



CAPSTONE COLLEGIATE COMMUNITIES / JJSC LLC

EUCLID AND SPEEDWAY


HISTORICAL HOUSES RELOCATION PROJECT

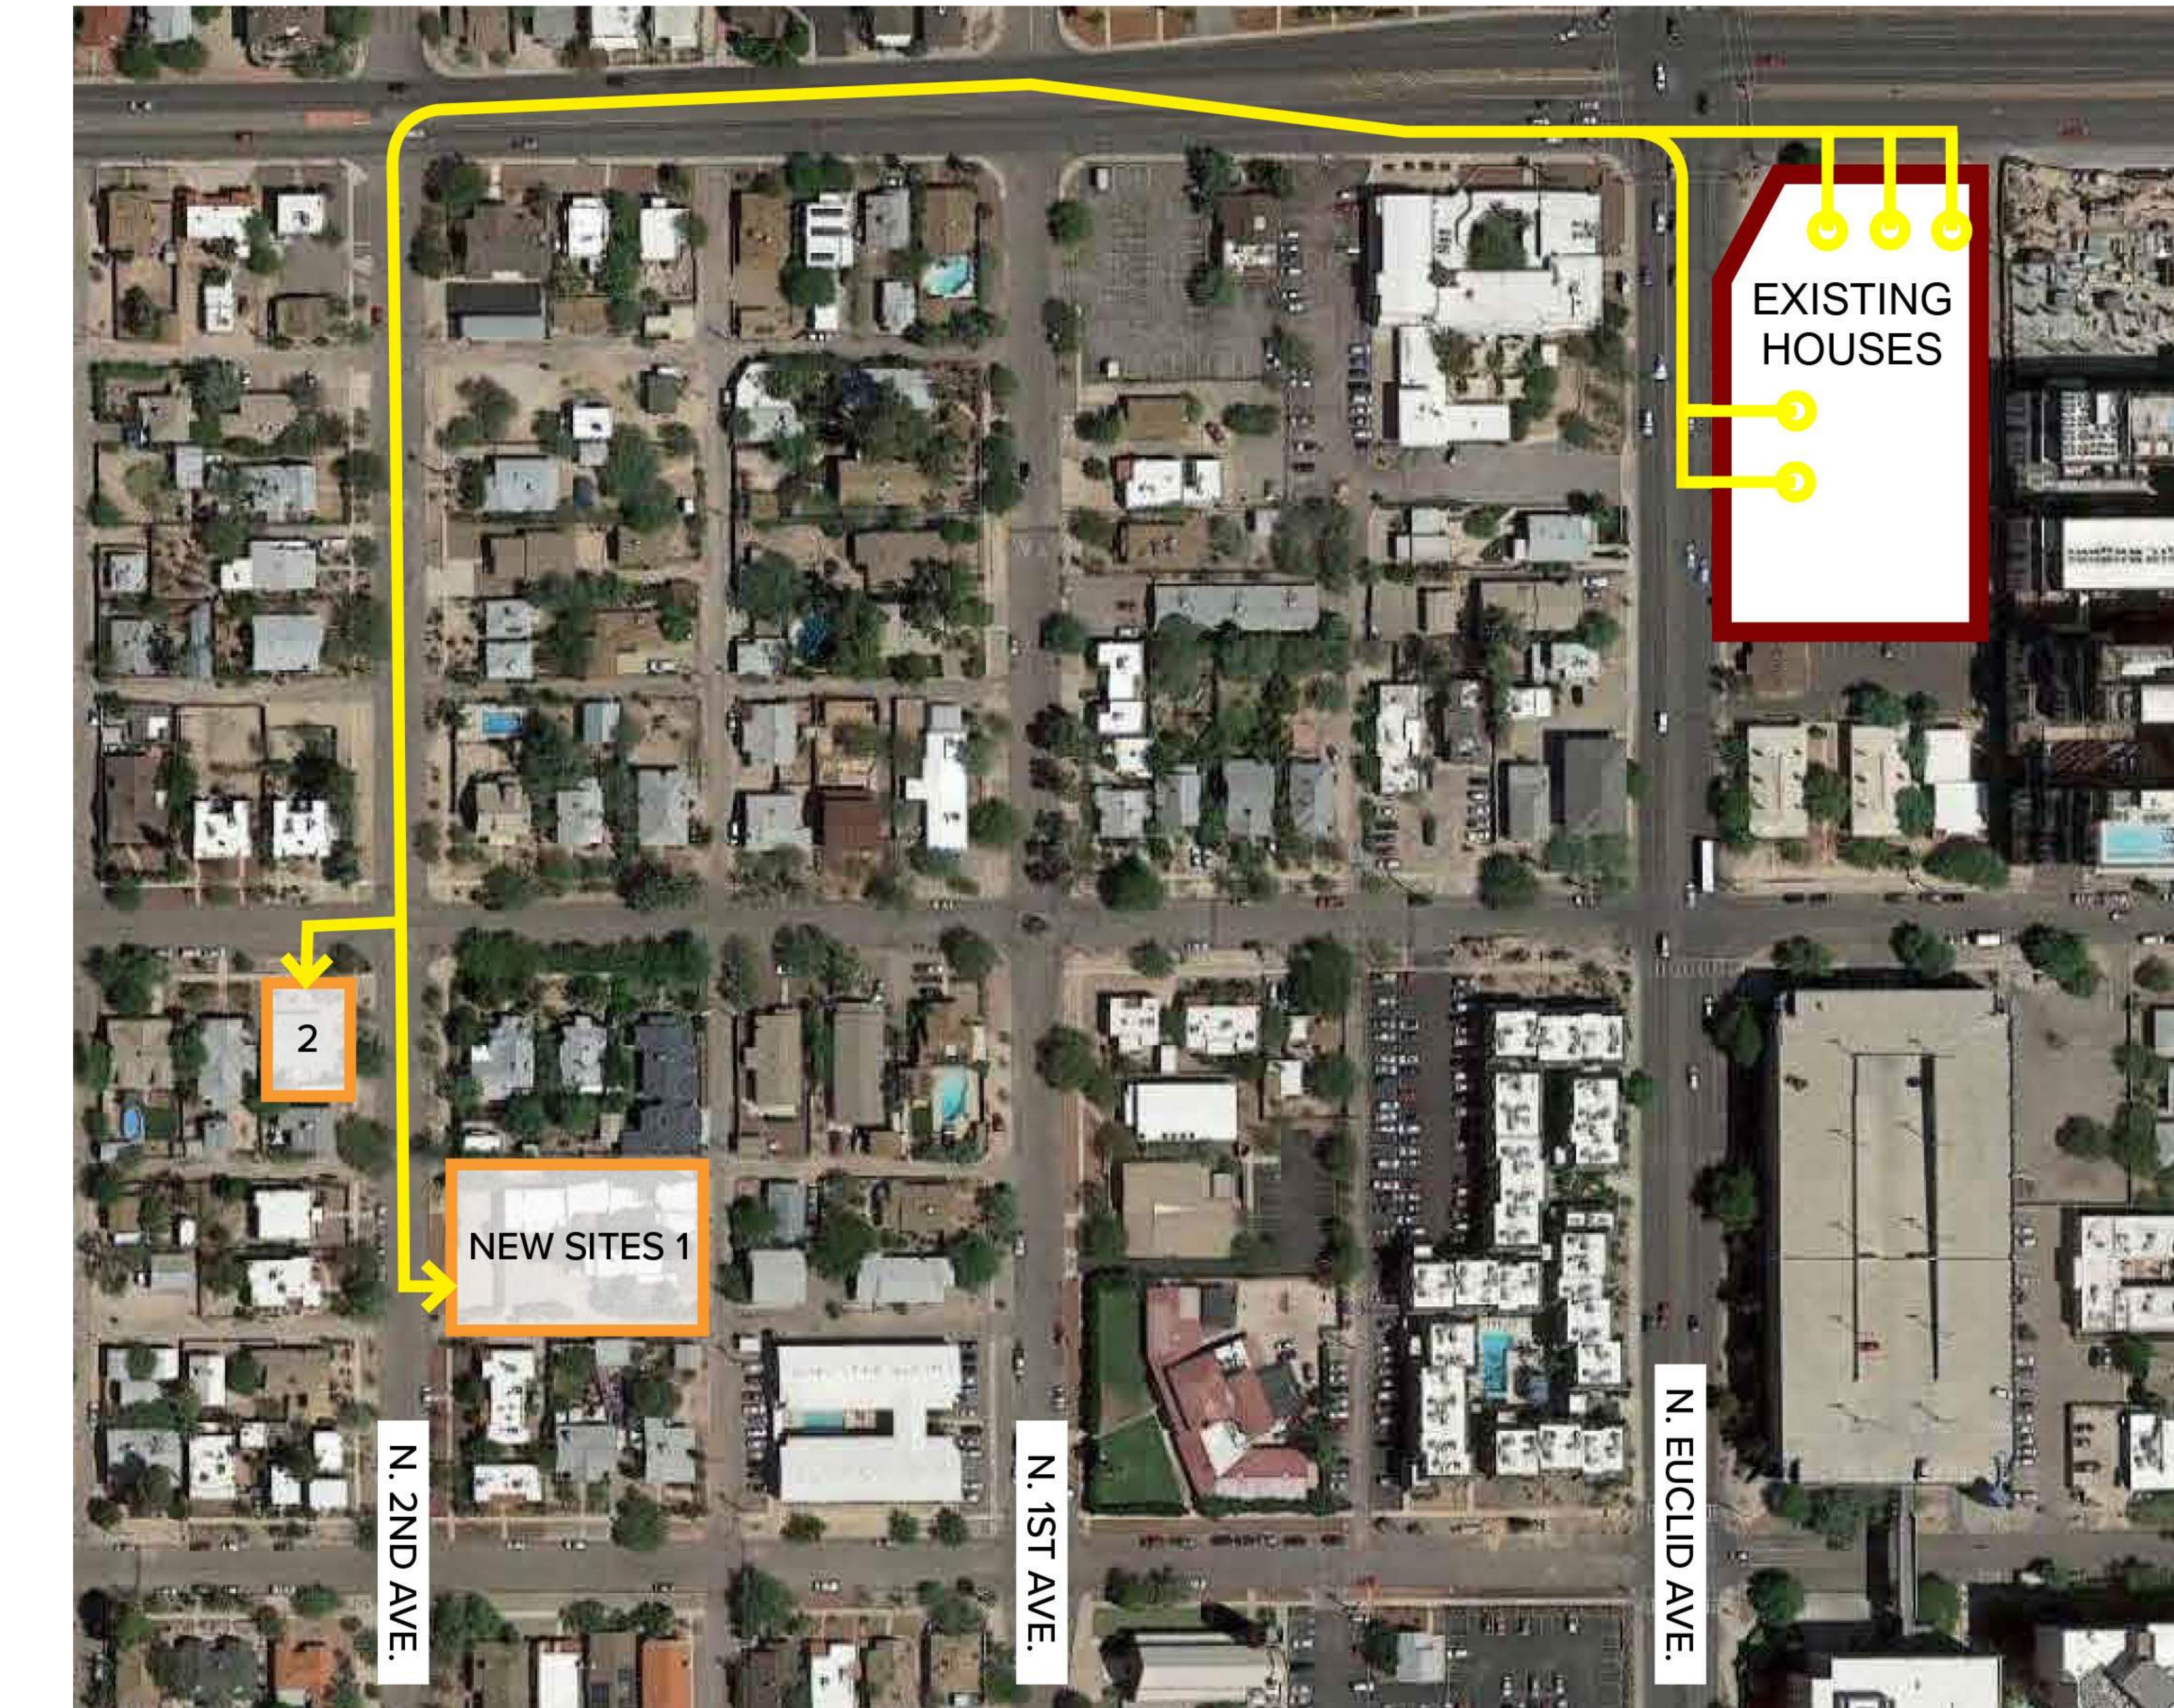

925 N Jacobus

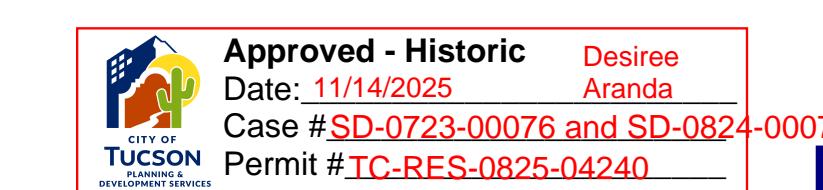

Approved as noted: (1) The openings around the stone foundation shall be natural edge;
(2) The vents shall be centered under the window assembly per the approved plans reviewed under Historic sub-record:
SD-0824-00078.

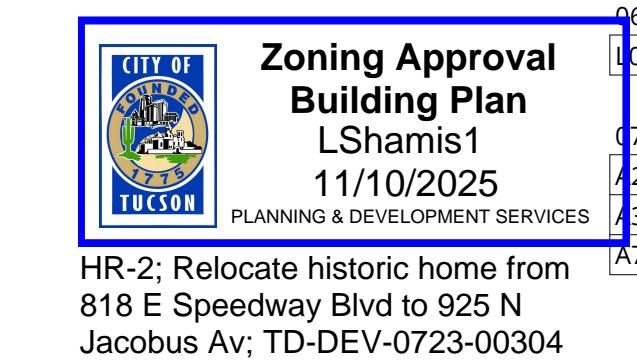

NOT FOR
CONSTRUCTION



38 NORTHWEST DAVIS, SUITE 300
PORTLAND, OR 97209
503.245.7100

1505 5TH AVE, SUITE 300
SEATTLE, WA 98101
206.576.1600

1014 HOWARD STREET
SAN FRANCISCO, CA 94103
415.252.7063

© ANKROM MOISAN ARCHITECTS, INC.

GENERAL NOTES - RELOCATION

PROCEDURE FOR RELOCATION

THE PROCESS OF MOVING WILL BE ACCOMPLISHED IN A SEQUENCE BASED ON THE NEW LOCATIONS FOR EACH HOUSE (TO BE DETERMINED).

THE INITIAL STEP REQUIRES MINOR EXCAVATION AND GRADING AROUND EACH HOUSE TO FACILITATE ACCESS FOR PLACING STEEL I-BEAMS UNDER THE HOUSE. NOTCHES WILL BE CUT IN THE STEM WALLS TO ALLOW FOR THE INSERTION OF STEEL BEAMS. THE BEAMS ARE THEN SUPPORTED BY A SECOND SET OF BEAMS THAT ARE FASTENED TOGETHER TO CREATE A SOLID PLATFORM BASE UNDER EACH HOUSE. THE HOUSES WILL BE LIFTED FROM BELOW AT THE BASE OF THE MAIN SILL PLATE AND FLOOR JOINTS, SHIMMED AS REQUIRED. THE STEEL PLATFORM BASE IS THEN LIFTED AND ATTACHED TO A TRUCK FOR THE ACTUAL MOVE. IN CASES WHERE THERE IS A VENEER OF TUFAS OR COBBLESTONE, THIS WILL BE REMOVED, OR IF THE STEM WALL IS STRUCTURAL, THE TUFAS OR COBBLESTONE STEM WALL WILL BE DISASSEMBLED AND RELOCATED.

AS NOTED BELOW, IN SOME CASES THE PORCH ROOFS WILL BE REMOVED FROM THE "MAIN BLOCK" OF THE HOUSE AND THE MATERIALS SALVAGED FOR POTENTIAL REUSE. IN OTHER CASES, THE PORCHES ARE INTEGRAL TO THE PREDOMINANT ROOF STRUCTURE AND WILL BE SUPPORTED WITH STEEL BRACING INTEGRATED WITH THE STEEL BASE.

NON-HISTORIC ADDITIONS WILL BE REMOVED AND THOSE WALL SECTIONS RESTORED TO THEIR ORIGINAL APPEARANCE AS PART OF THE REHABILITATION.

MOVE ROUTE
IN GENERAL, THE HOUSES WILL BE TOWED FROM THEIR CURRENT SITE ONTO EITHER SPEEDWAY OR EUCLID AND MANEUVERED TO PROCEED WEST ON SPEEDWAY. THIS WILL REQUIRE TEMPORARY BLOCKING OF TRAFFIC AND LIKELY TEMPORARY RELOCATION OF STREETLIGHTS. THE ROUTE WILL TURN SOUTH ON SECOND AVENUE FOR TWO BLOCKS BEFORE ARRIVING AT THE NEW SITE. SOME TRIMMING OF TREES WILL BE REQUIRED, AS WELL AS ALL CARS PROHIBITED FROM PARKING ON THE STREET. THE MOVES ARE EXPECTED TO OCCUR OVERNIGHT, OVER A FIVE-WEEK PERIOD. THE EXACT SCHEDULE WILL BE DETERMINED VIA CITY ROW USE PERMIT PROCESS.

PREPARATION WORK FOR NEW LOCATION
NEW FOOTINGS WILL BE CONSTRUCTED PRIOR TO THE MOVE. FOUNDATIONS/STEM WALLS WILL THEN BE BUILT UP TO THE BASE OF EACH HOUSE SO THEY CAN BE SET IN PLACE. FOUNDATION SHEATHING WILL OCCUR AS PART OF THE REHABILITATION, AS NOTED BELOW. AT THE 928 N. SECOND AVENUE SITE, AN EXISTING RETAINING WALL WILL NEED TO BE REMOVED AND THE LAND GRADED TO ALLOW ACCESS FOR THE HOUSES. THE SITE WILL NEED TO BE REGRADED, STABILIZED AND COMPACTED. THE RETAINING WALL WILL NEED TO BE RECONSTRUCTED. SPECIFICS ON WORK REQUIRED FOR THE MOVE OF EACH HOUSE ARE OUTLINED IN THE COMING PAGES.

EXTERIOR REHABILITATION OF HOUSES
THE MOVE PROCEDURE WILL REQUIRE REMOVAL OF CERTAIN FEATURES, NOTABLY PORCHES AND OTHER PROJECTIONS, THAT ARE NOT INTEGRAL TO THE STRUCTURAL FRAME OF THE HOUSE.

THERE ARE ALSO CERTAIN GENERAL CONDITIONS PERTAINING TO THE MOVE PROCEDURE. WINDOWS SHALL BE CONSIDERED TO BE PART OF THE PRIMARY STRUCTURE AND WILL BE MOVED AS PART OF THE MAIN BLOCK. THE WINDOWS WILL BE BOARDED WITH 1/2" OSB PRIOR TO THE MOVE FOR PROTECTION AND STABILITY. CRACKED OR BROKEN GLASS WILL BE REPLACED AS NEEDED AFTER THE MOVE. PORCH FLOORS AND STAIRS THAT ARE SCORED CONCRETE WILL NOT BE MOVED, BUT WILL BE REPLICATED TO MATCH THE ORIGINAL MATERIAL. ALL ROOFS WILL BE MOVED WITH THE HOUSE, BUT HOUSES MAY NEED NEW ROOF SHEATHING TO BE APPLIED AT THE NEW LOCATION. THE NEW SITE WILL BE FENCED FOR SECURITY, TYPICAL OF ANY CONSTRUCTION SITE.

SEE PLANS AND ELEVATIONS FOR THE SPECIFIC ARCHITECTURAL FEATURES OF THE HOUSES TO BE RESTORED/REPAIRED ON EACH HOUSE IN ORDER TO RETAIN THE INTEGRITY OF THE HISTORIC APPEARANCE.

SHEET INDEX

NUMBER	SHEET NAME		HP REVIEW
00 GENERAL			
G0.01	SHEET INDEX		<input checked="" type="checkbox"/>
A3.51	STREET ELEVATIONS	<input checked="" type="checkbox"/>	<input type="checkbox"/>
01 CIVIL			
C101	SITE PLAN	<input checked="" type="checkbox"/>	<input type="checkbox"/>
02 LANDSCAPE			
L01	LANDSCAPE GENERAL NOTES	<input checked="" type="checkbox"/>	<input type="checkbox"/>
L02	PLANTING PLAN	<input checked="" type="checkbox"/>	<input type="checkbox"/>
L03	PLANTING DETAILS	<input checked="" type="checkbox"/>	<input type="checkbox"/>
L04	IRRIGATION PLAN	<input checked="" type="checkbox"/>	<input type="checkbox"/>
L05	IRRIGATION DETAILS	<input checked="" type="checkbox"/>	<input type="checkbox"/>
L06	WATER HARVESTING PLAN	<input checked="" type="checkbox"/>	<input type="checkbox"/>
04 ARCHITECTURAL			
A2.01	1036 - FLOOR PLANS AND SCHEDULES	<input checked="" type="checkbox"/>	<input type="checkbox"/>
A2.02	812 - FLOOR PLANS AND SCHEDULES	<input checked="" type="checkbox"/>	<input type="checkbox"/>
A2.03	814 - FLOOR PLANS AND SCHEDULES	<input checked="" type="checkbox"/>	<input type="checkbox"/>
A2.04	818 - FLOOR PLANS AND SCHEDULES	<input checked="" type="checkbox"/>	<input type="checkbox"/>
A3.01	1036 - RELO ELEVATIONS	<input checked="" type="checkbox"/>	<input type="checkbox"/>
A3.02	812 - RELO ELEVATIONS	<input checked="" type="checkbox"/>	<input type="checkbox"/>
A3.03	814 - RELO ELEVATIONS	<input checked="" type="checkbox"/>	<input type="checkbox"/>
A3.04	818 - RELO ELEVATIONS	<input checked="" type="checkbox"/>	<input type="checkbox"/>
A3.06	928 - EXISTING ELEVATIONS	<input checked="" type="checkbox"/>	<input type="checkbox"/>
A7.21	1036 - DETAILS	<input checked="" type="checkbox"/>	<input type="checkbox"/>
A7.22	812 - DETAILS	<input checked="" type="checkbox"/>	<input type="checkbox"/>
A7.22A	812 - DETAILS	<input checked="" type="checkbox"/>	<input type="checkbox"/>
A7.23	814 - DETAILS	<input checked="" type="checkbox"/>	<input type="checkbox"/>
A7.24	818 - DETAILS	<input checked="" type="checkbox"/>	<input type="checkbox"/>
05 CIVIL			
C101a	SITE PLAN - 548	<input checked="" type="checkbox"/>	<input type="checkbox"/>
06 LANDSCAPE			
L01a	LANDSCAPE PLAN - 548	<input checked="" type="checkbox"/>	<input type="checkbox"/>
07 ARCHITECTURAL			
2.05	1040-1042 - FLOOR PLANS AND SCHEDULES	<input checked="" type="checkbox"/>	<input type="checkbox"/>
2.06	1040-1042 - RELO ELEVATIONS	<input checked="" type="checkbox"/>	<input type="checkbox"/>
A7.25	1040-1042 - DETAILS	<input checked="" type="checkbox"/>	<input type="checkbox"/>

TUCSON SPEEDWAY HISTORICAL HOUSES RELOCATION

Tucson, AZ

Capstone Collegiate Communities/JJSC LLC

SHEET INDEX

DATE	REASON FOR ISSUE
04/09/2024	


PROJECT NUMBER
184170

SHEET NUMBER
184170

G0.01

LANDSCAPE BUFFERYARD TABLE

BUFFER	BORDER TYPE	WIDTH	BORDER LENGTH	BORDER AREA	TREES REQ'D	TREES PROVIDED	SHRUB COVERAGE REQ'D	SHRUB COVERAGE PROVIDED	SCREENING ELEMENT PROVIDED
2ND AVE.	STREET	10'	100 LF	1,000 SF	3	4	500 SF	500+ SF	30" VEGETATIVE SCREEN

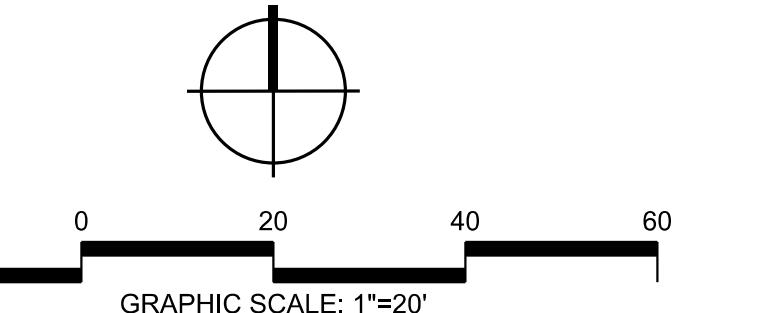

PLANT MATERIAL LEGEND

SYMBOL	BOTANICAL NAME	COMMON NAME	QTY.	SIZE	H x W (CALIPER)
+	ACACIA ANEURA	MULGA ACACIA	4	15 GAL.	4" x 2" (.5")
*	PROSOPIS VELUTINA	VELVET MESQUITE	4	15 GAL.	5.5" x 3" (.5")

SYMBOL	BOTANICAL NAME	COMMON NAME	QTY.	SIZE
*	ALOE x 'BLUE ELF'	BLUE ELF ALOE	30	5 GAL.
*	AGAVE OCAHUI	OCAHUI AGAVE	13	5 GAL.
*	ASCLEPIAS SUBULATA	DESERT MILKWEED	3	5 GAL.
*	CALLIANDRA ERIOPHYLLA	FAIRY DUSTER	15	5 GAL.
*	DALEA FRUTESCENS	BLACK DALEA	6	5 GAL.
*	DALEA GREGGII	TRAILING INDIGO BUSH	5	5 GAL.
*	DASYLIRION WHEELERI	DESERT SPOON	2	5 GAL.
*	ENCELIA FARINOSA	BRITTLE BUSH	16	5 GAL.
*	EUPHOBIA ANTISYPHILITICA	CANDELILLA	5	5 GAL.
■	FEROCACTUS WISLizenii	BARREL CACTUS	5	5 GAL.
*	HESPERALOE PARVIFLORA	RED YUCCA	4	5 GAL.

SYMBOL	BOTANICAL NAME	COMMON NAME	QTY.	SIZE
Ⓐ	JUSTICIA CALIFORNICA	CHUPAROSA	2	5 GAL.
✿	OPUNTIA ENGELMANNII	ENGELMANN PRICKLY PEAR CACTUS	1	5 GAL.
ⓧ	PENSTEMON PARRYI	PARRY'S PENSTEMON	21	1 GAL.

A MIN. 2" DEPTH LAYER OF DECORATIVE ROCK SHALL BE PLACED IN ALL PLANTING AREAS INDICATED ON THE PLANS. DO NOT PLACE DECORATIVE ROCK IN BASIN BOTTOMS. SIZE SHALL BE 3/4" SCREENED. COLOR SHALL BE 'DESERT GOLD' OR AS APPROVED BY OWNER.


10' STREET LANDSCAPE BORDER W/ 30" VEGETATIVE SCREEN

EXISTING RETAINING WALL TO BE REMOVED TO RELOCATE HOMES AND REBUILT PER DETAIL BELOW


USA STAMP TO BE WPA PRESERVED

NOTE: IF EXISTING TREES BETWEEN CURB AND SIDEWALK ARE NOT REMOVED TO FACILITATE BUILDING RELOCATION, THEY MAY REMAIN IN PLACE IN LIEU OF INSTALLING NEW TREES TO MEET THE STREET LANDSCAPE BORDER REQUIREMENTS.

NOTE: ALL NEW CONCRETE SIDEWALKS WILL BE GREY PORTLAND CEMENT COLORED - NO COLORANT ADDED.

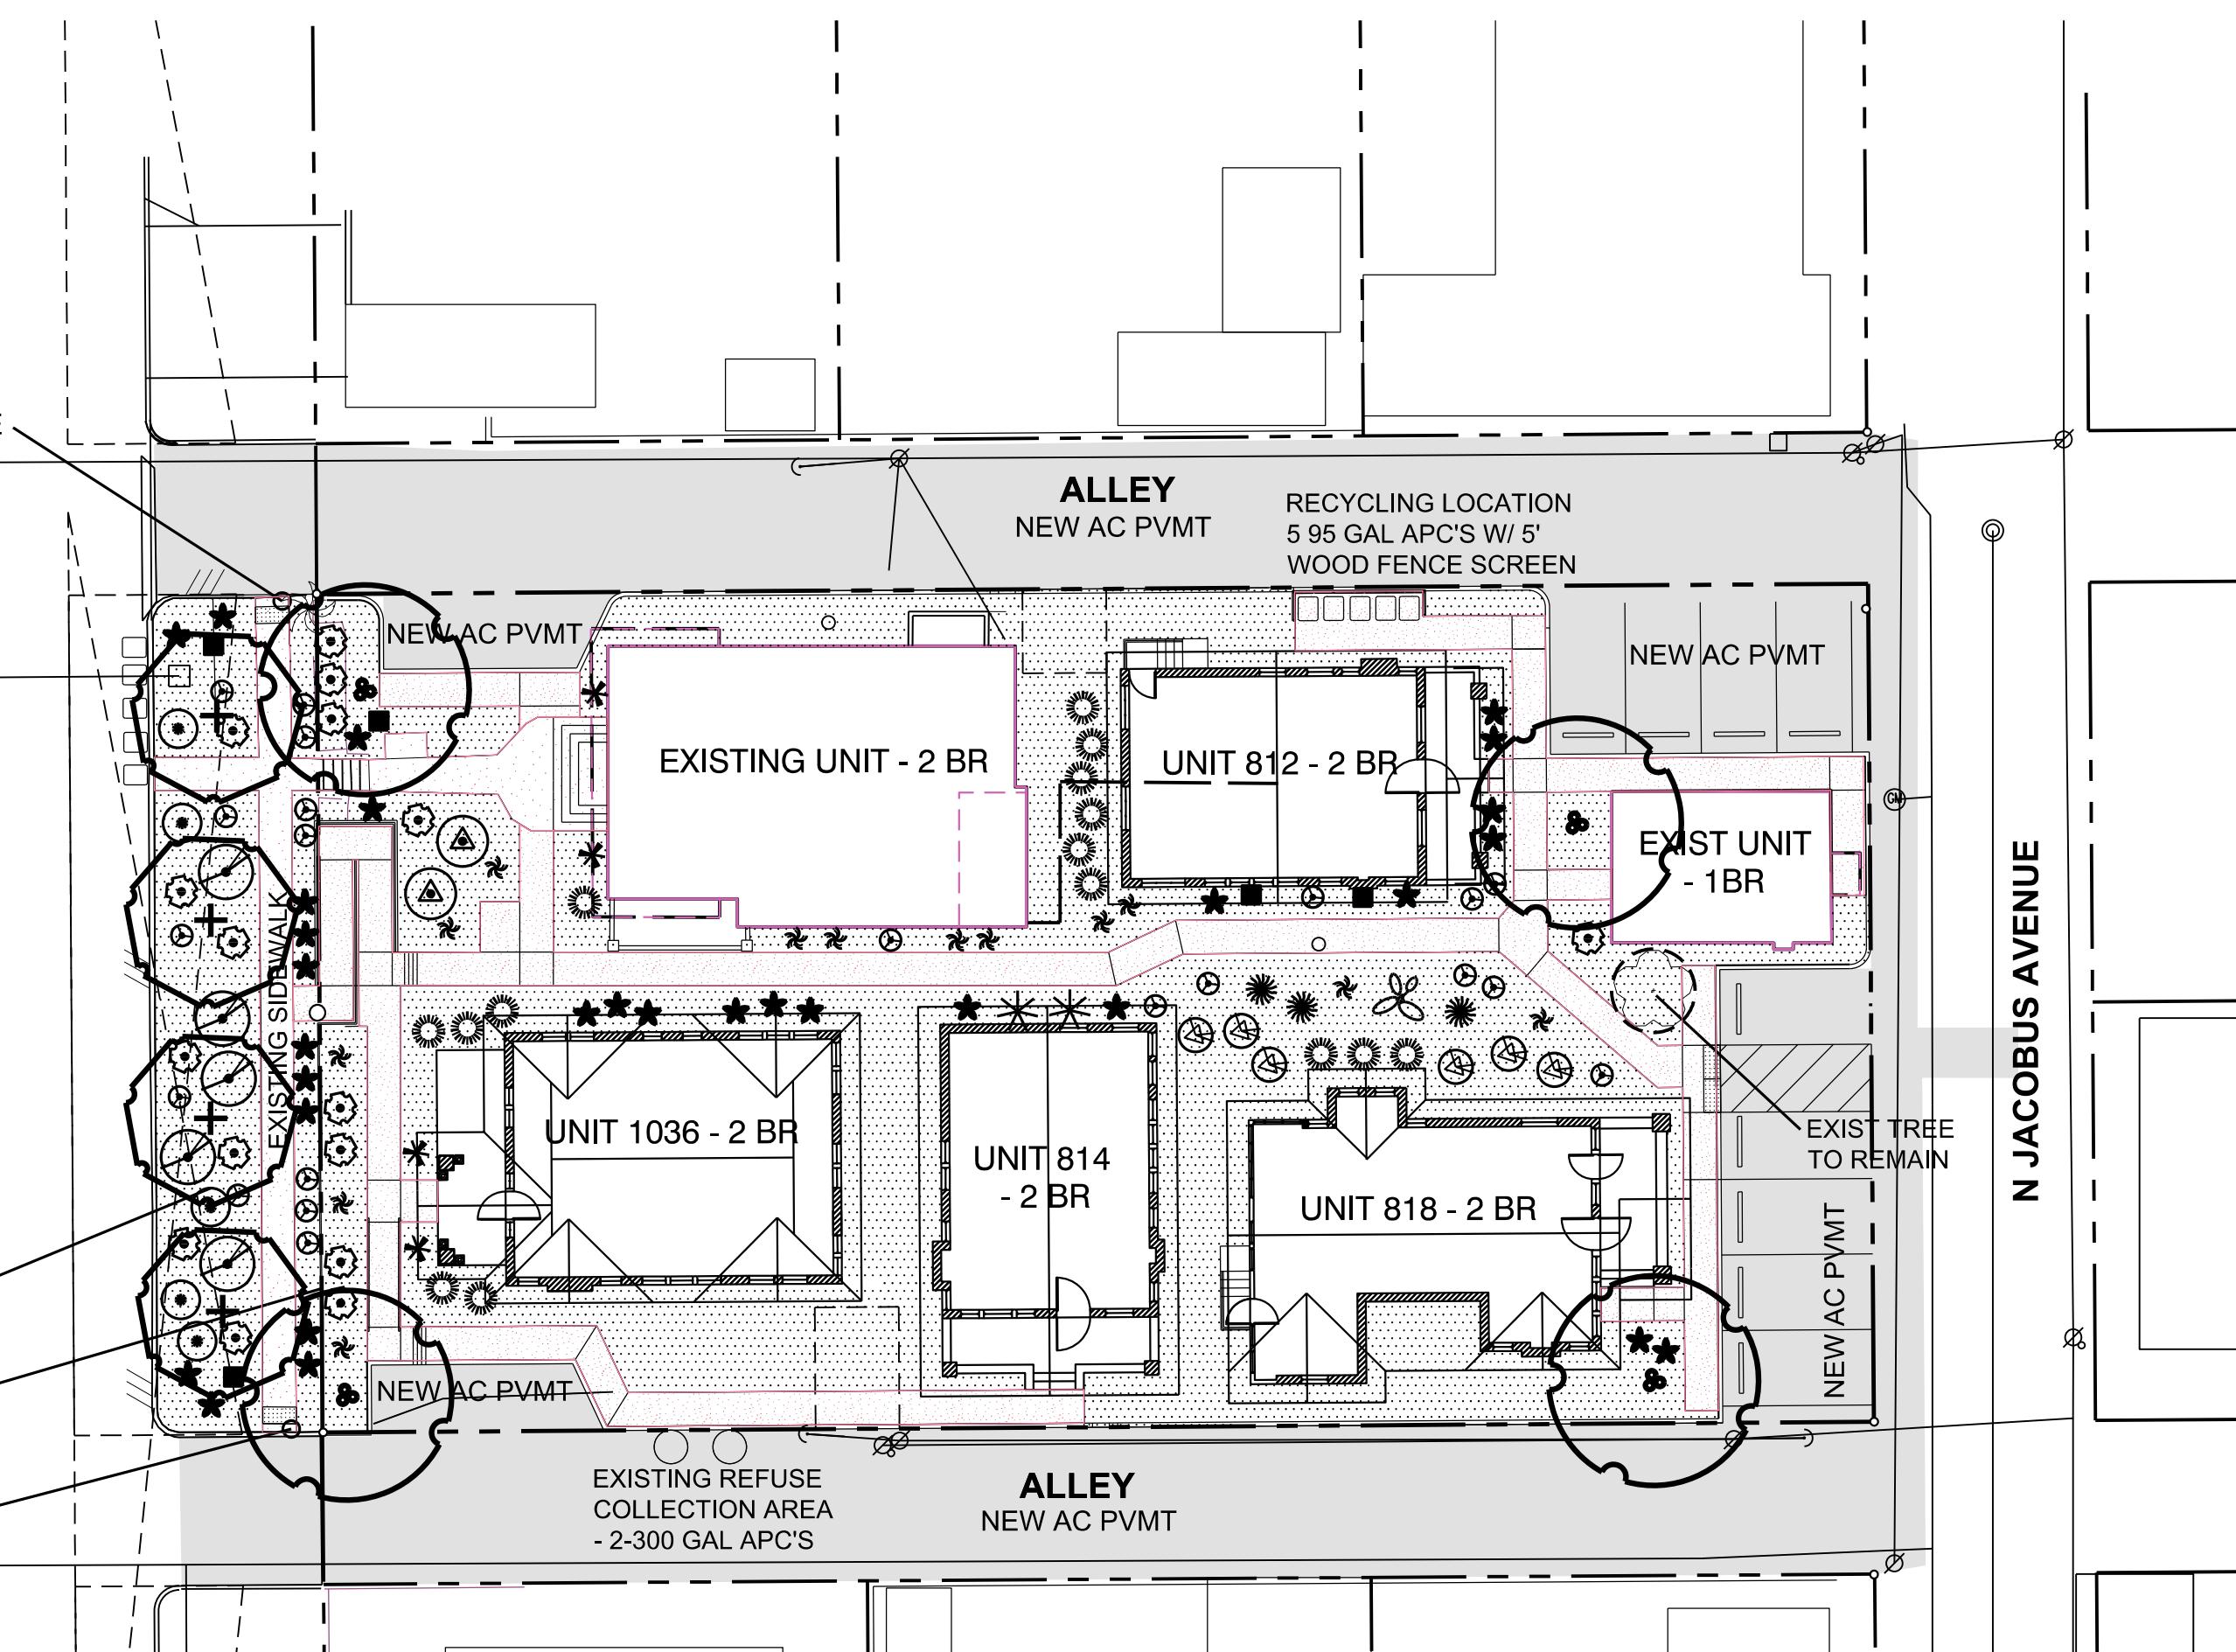

CODE COMPLIANT LANDSCAPE PLAN EXHIBIT

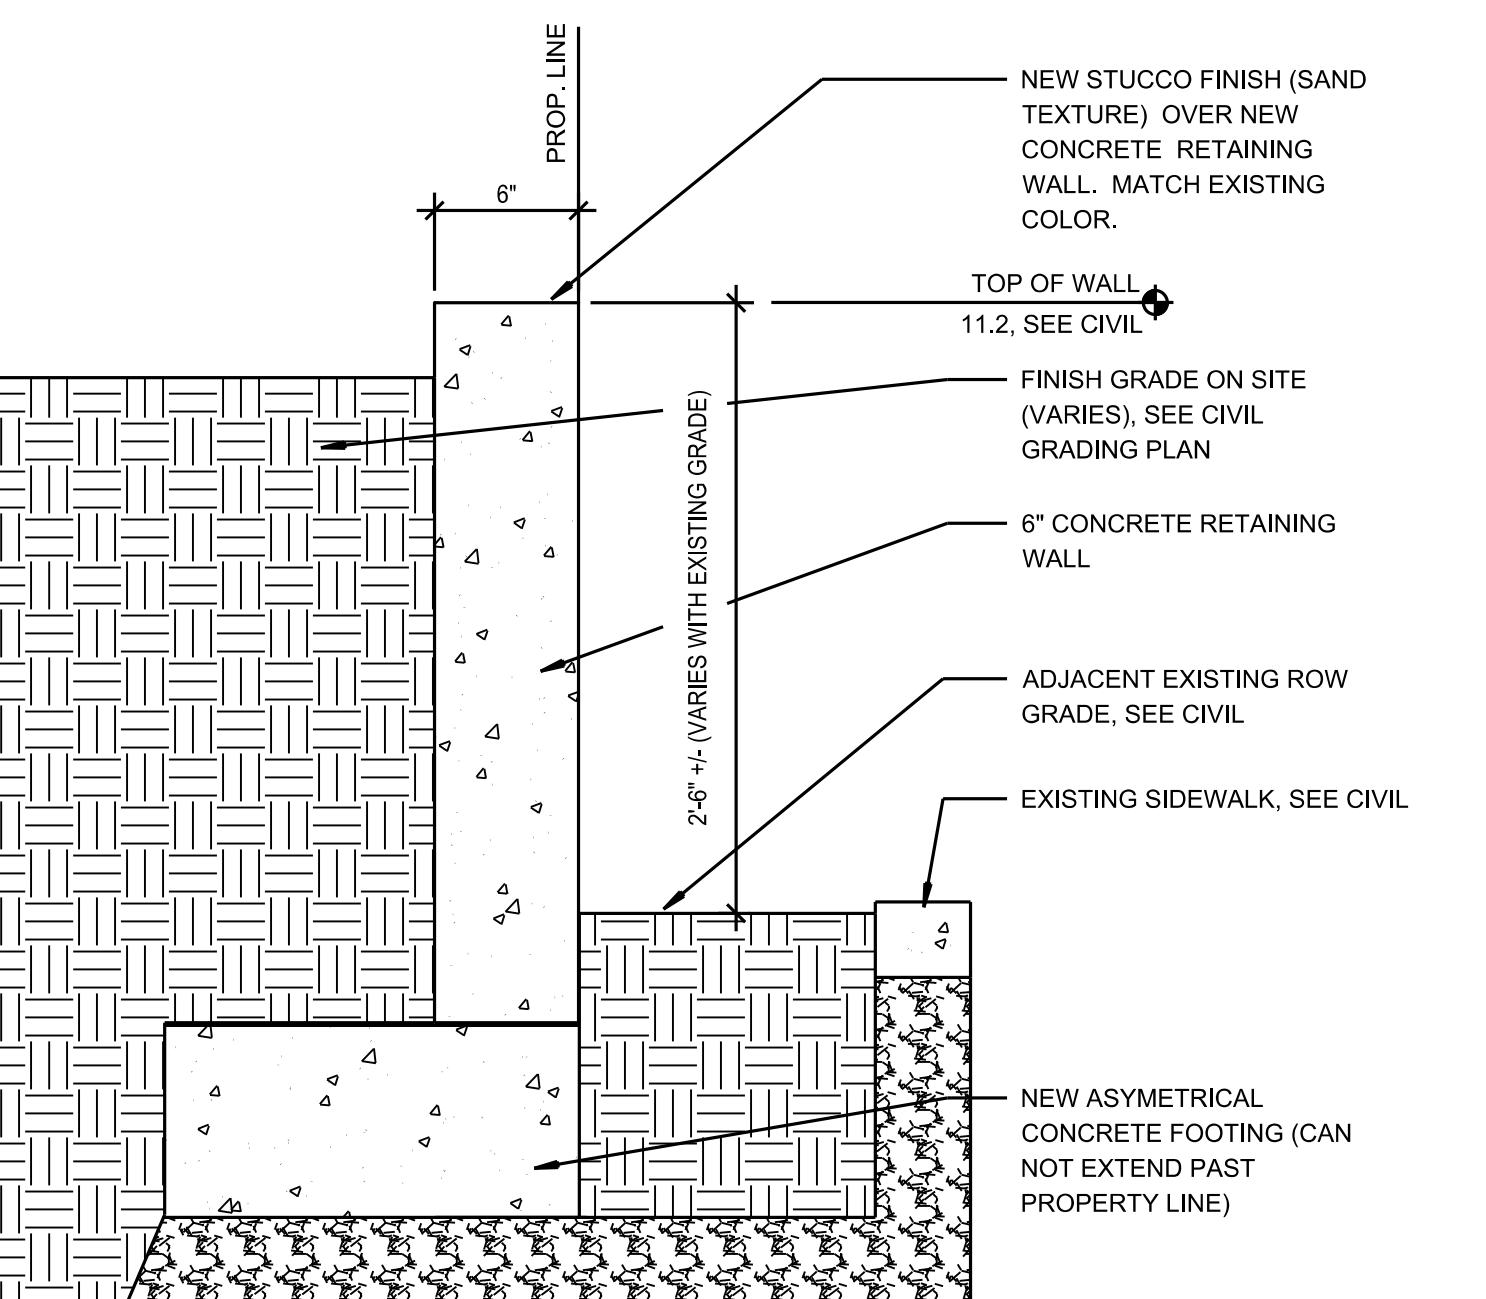

RELATED CASE # C9-83-49

RETAINING WALL DETAIL

(SEE ARCHITECTURAL PLANS)

Approved - Historic	Desiree
Date: 11/14/2025	Aranda
Case #	
Permit #	

REVIEWED FOR	BUILDING CODE
COMPLIANCE	
K. Van Karsen	
11/10/2025	


APPR DATE	APRIL 2024
REVISION	1
NO. BY DATE	NO. BY DATE
PRELIMINARY	
3945 EAST FORT LOWELL ROAD - SUITE 111	
TUCSON, AZ 85711	
520-795-0000	
rickenkeng.com	
San Diego, Riverside, Orange, Santa Clarita, Sacramento, Phoenix, Las Vegas, Denver	
Tucson	
RICK	
ENGINEERING COMPANY	
LOTS 7 AND 10, BLOCK 22, CITY OF TUCSON	
RESUBDIVISION, BOOK 1, PAGE 19	
SECTION 12, TOWNSHIP 14, SOUTH, RANGE 13, EAST	
GILA & SALT RIVER MERIDIAN, PIMA COUNTY, ARIZONA	
LANDSCAPE EXHIBIT SHEET	
MULTI-FAMILY DEVELOPMENT	
TD-DEV-0723-00304	
SD-0723-00076	
TC-DMO-1123-00237	
HORIZ :	1" = 20'
VERT :	N/A
SHEET :	1 OF 1




1 EAST ELEVATION FROM JACOBUS AVE
1/8" = 1'-0"




2 NORTH ELEVATION FROM ALLEY
1/8" = 1'-0"

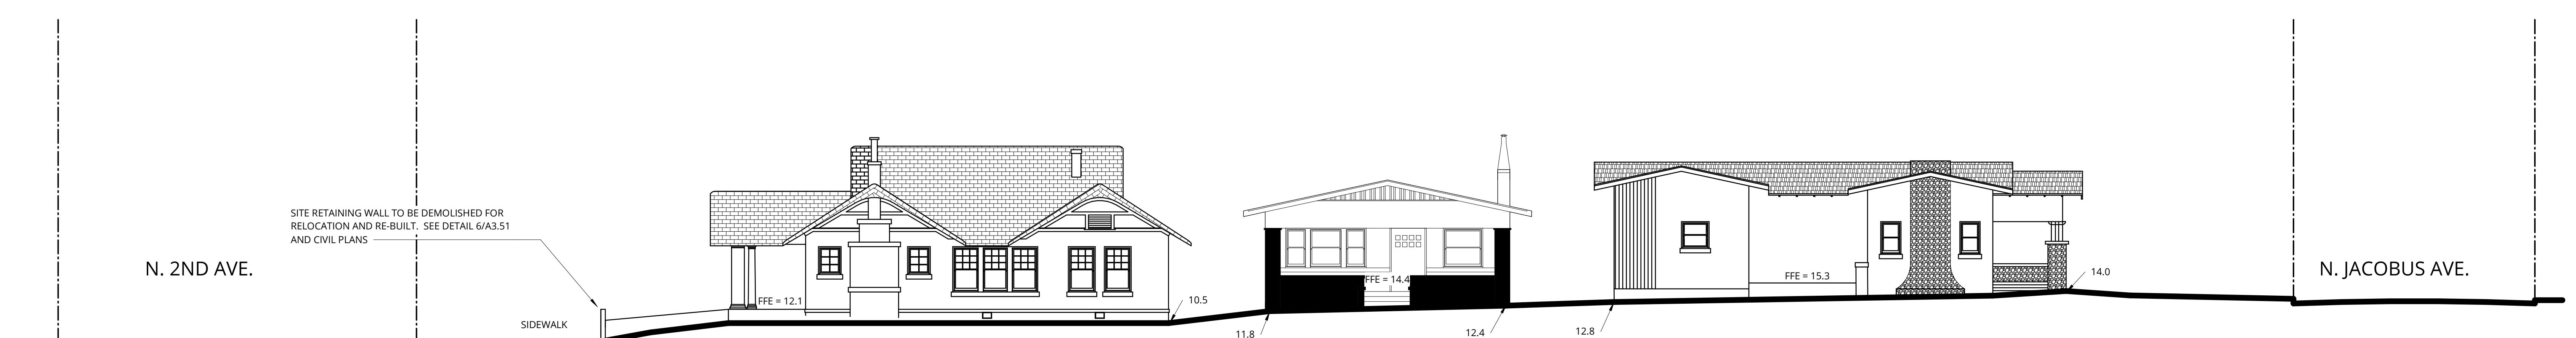

3 SOUTH ELEVATION FROM ALLEY
1/8" = 1'-0"

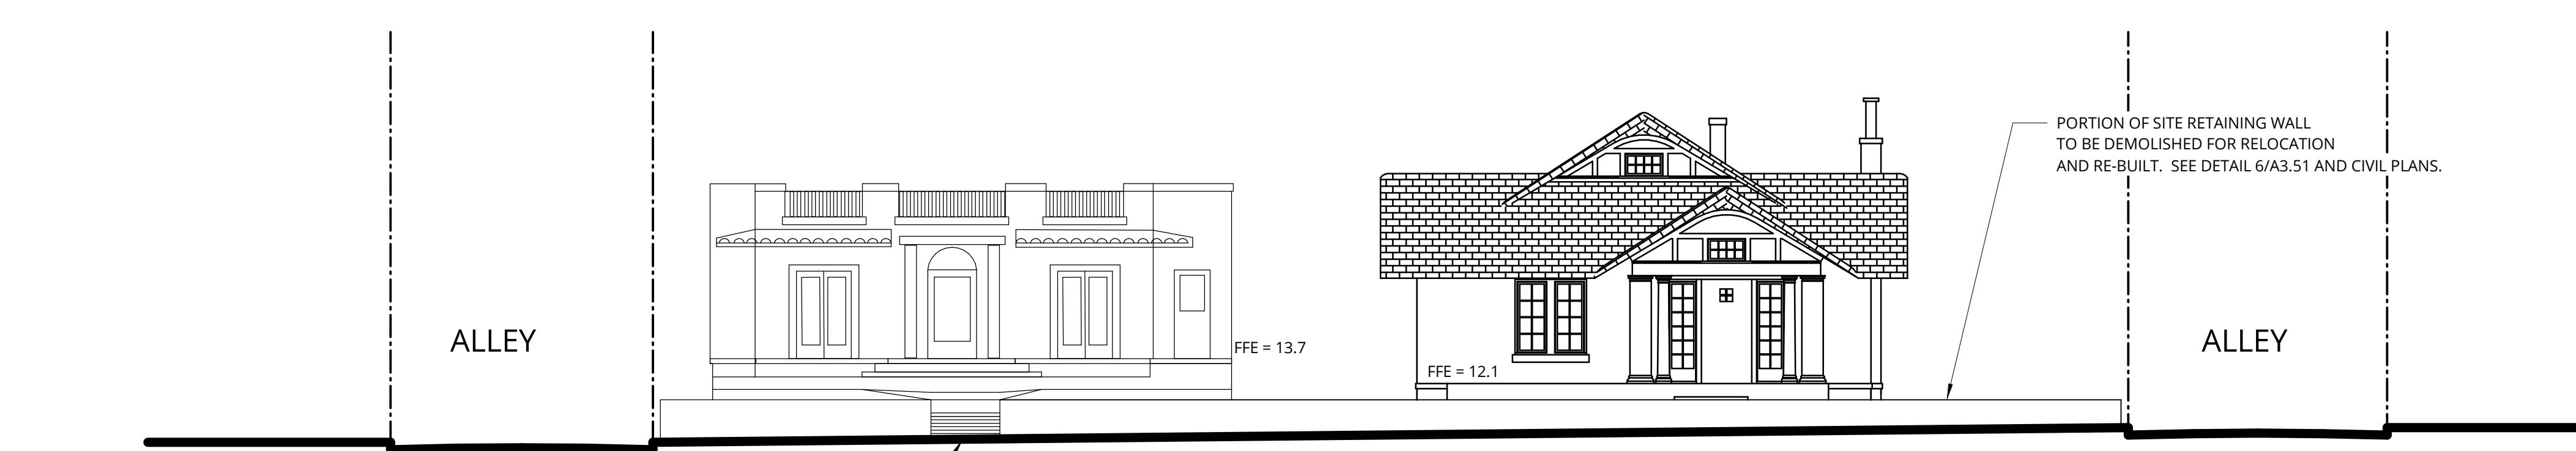

4 WEST ELEVATION FROM N 2ND AVE
1/8" = 1'-0"

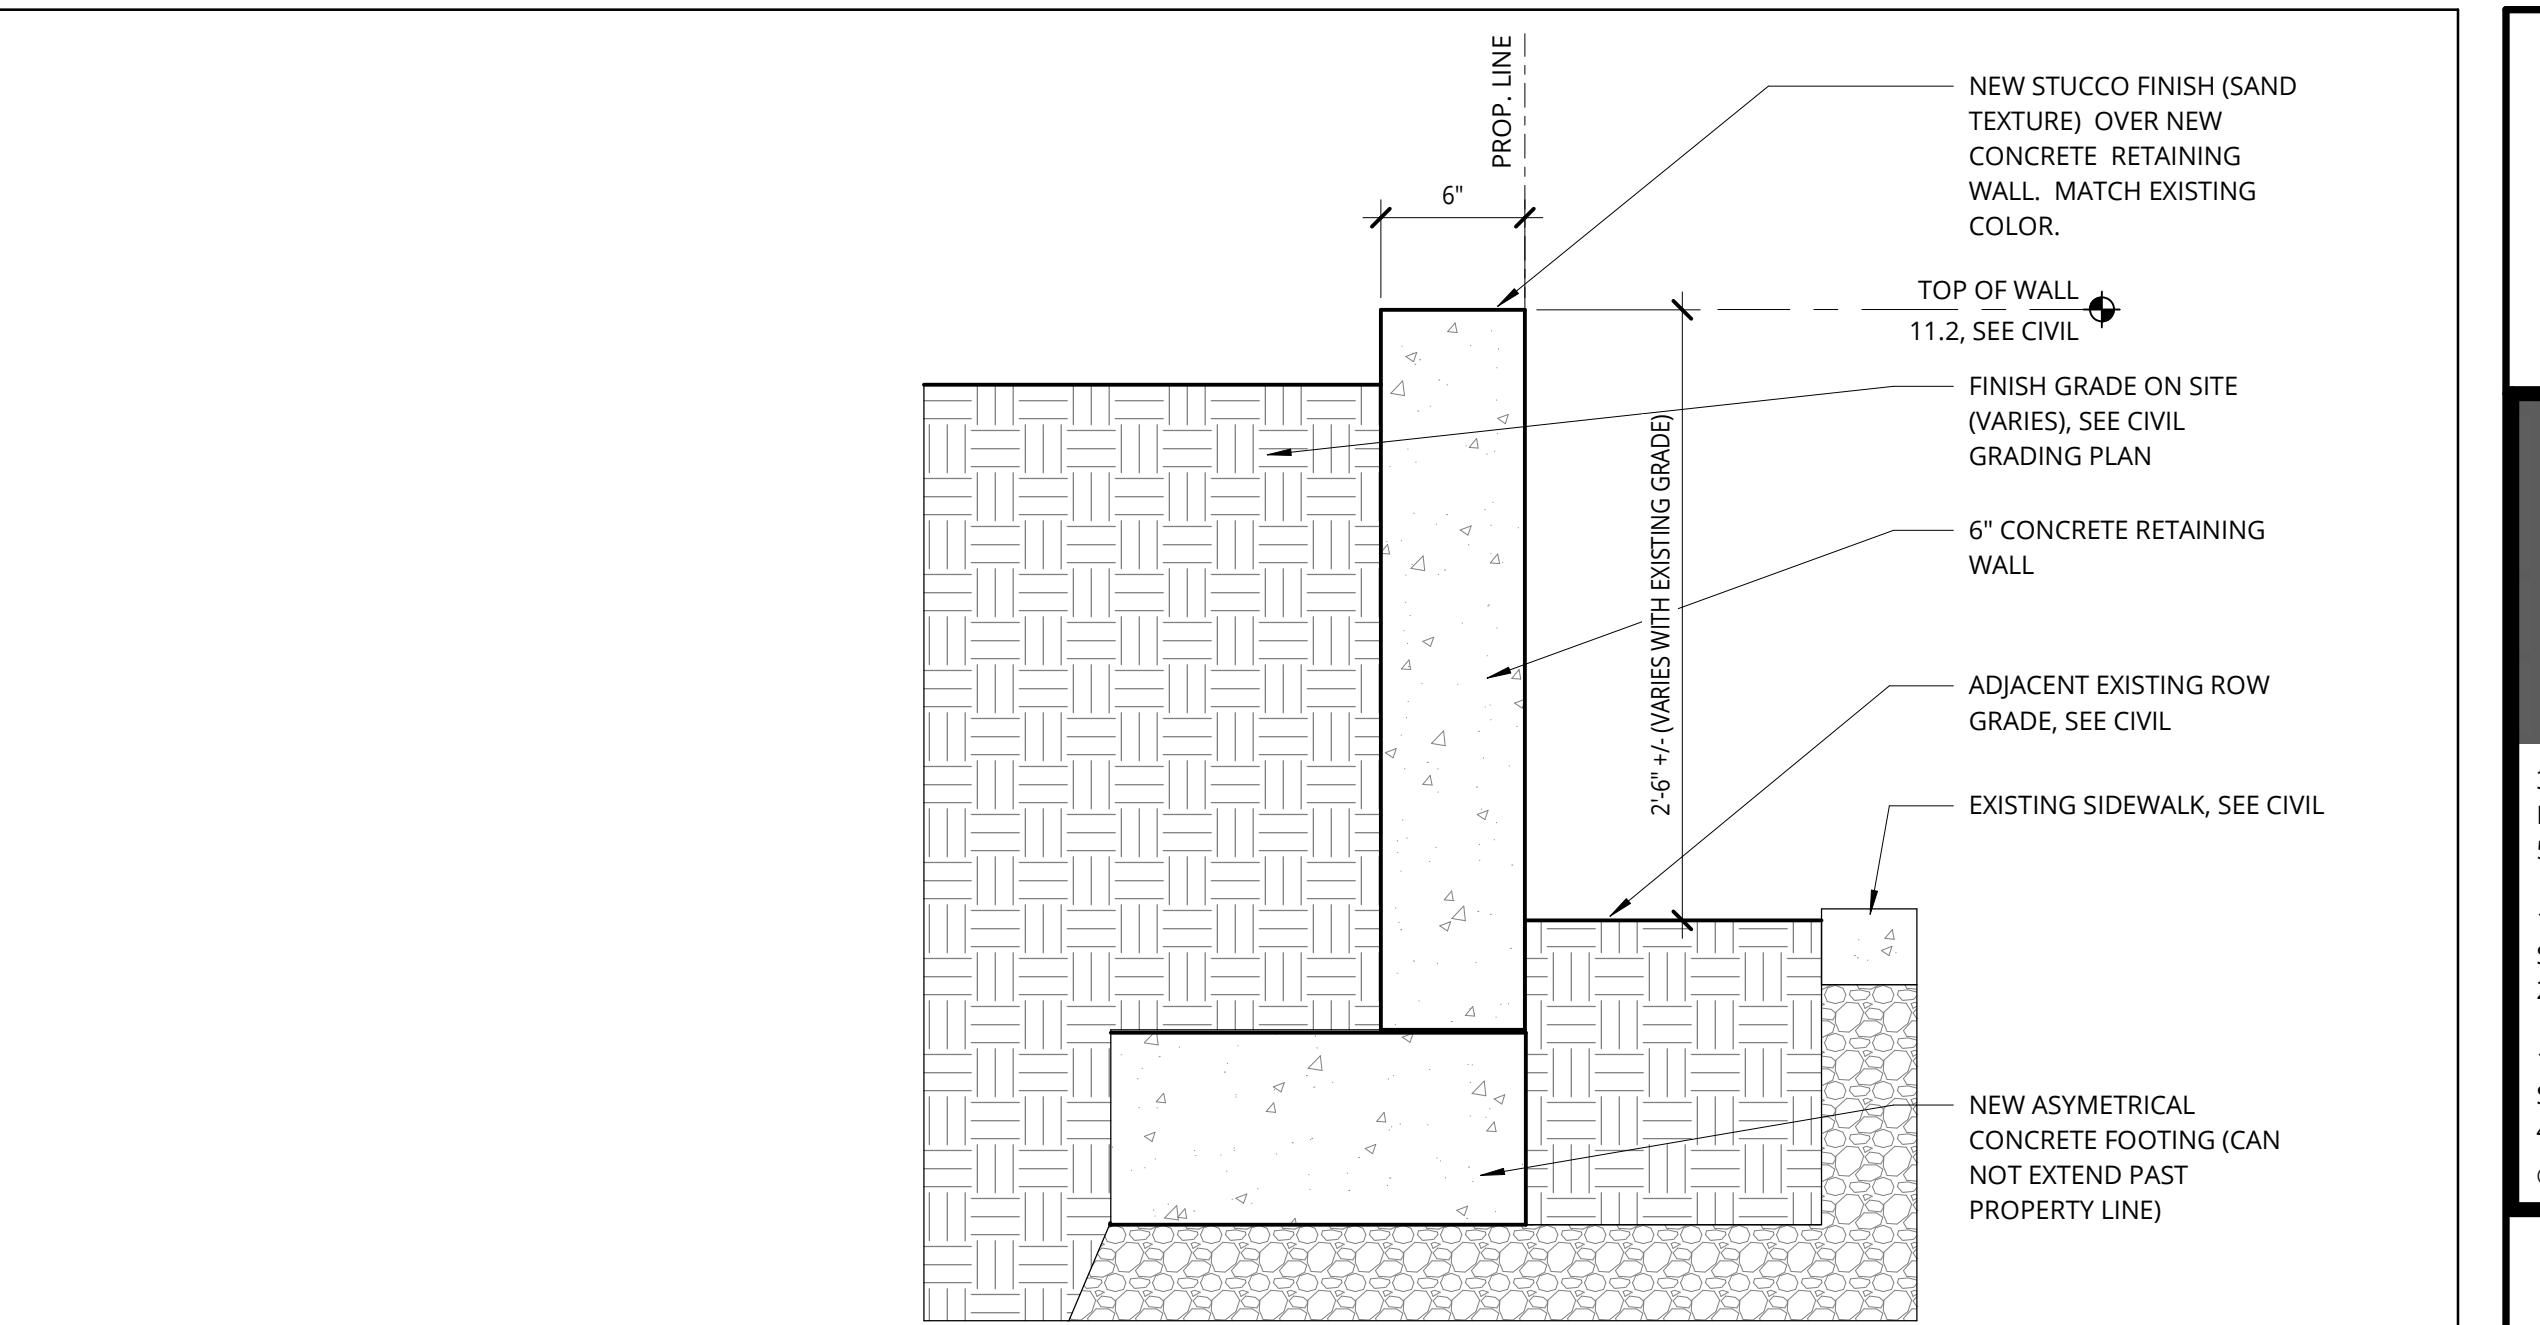

6 RETAINING WALL DETAIL - 2ND AVE.
1 1/2" = 1'-0"



5 KEY PLAN - STREET ELEVATIONS
1" = 40'-0"

TUCSON SPEEDWAY HISTORICAL HOUSES RELOCATION

Tucson, AZ

Capstone Collegiate Communities/JSC LLC

NOT FOR CONSTRUCTION



38 NORTHWEST DAVIS, SUITE 300
PORTLAND, OR 97209
503.245.7100

1505 5TH AVE, SUITE 300
SEATTLE, WA 98101
206.576.1600

1014 HOWARD STREET
SAN FRANCISCO, CA 94103
415.252.7063

© ANKROM MOISAN ARCHITECTS, INC.

REVISION	DATE	REASON FOR ISSUE

STREET ELEVATIONS

CONCEPT DESIGN

DATE
04/09/2024

PROJECT NUMBER
184170

SHEET NUMBER

A3.51

NOT FOR
CONSTRUCTION38 NORTHWEST DAVIS, SUITE 300
PORTLAND, OR 97209
503.245.71001505 5TH AVE, SUITE 300
SEATTLE, WA 98101
206.576.16001014 HOWARD STREET
SAN FRANCISCO, CA 94103
415.252.7063

© ANKROM MOISAN ARCHITECTS, INC.

TUCSON SPEEDWAY HISTORICAL HOUSES RELOCATION

Tucson Collegiate Communities/JSC LLC



REVISION	DATE	REASON FOR ISSUE

818 - FLOOR PLANS
AND SCHEDULES

CONCEPT DESIGN

DATE	PROJECT NUMBER
04/09/2024	184170

A2.04

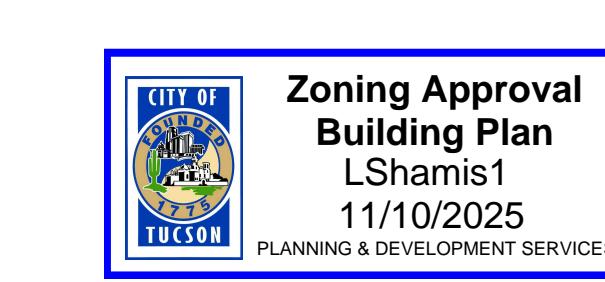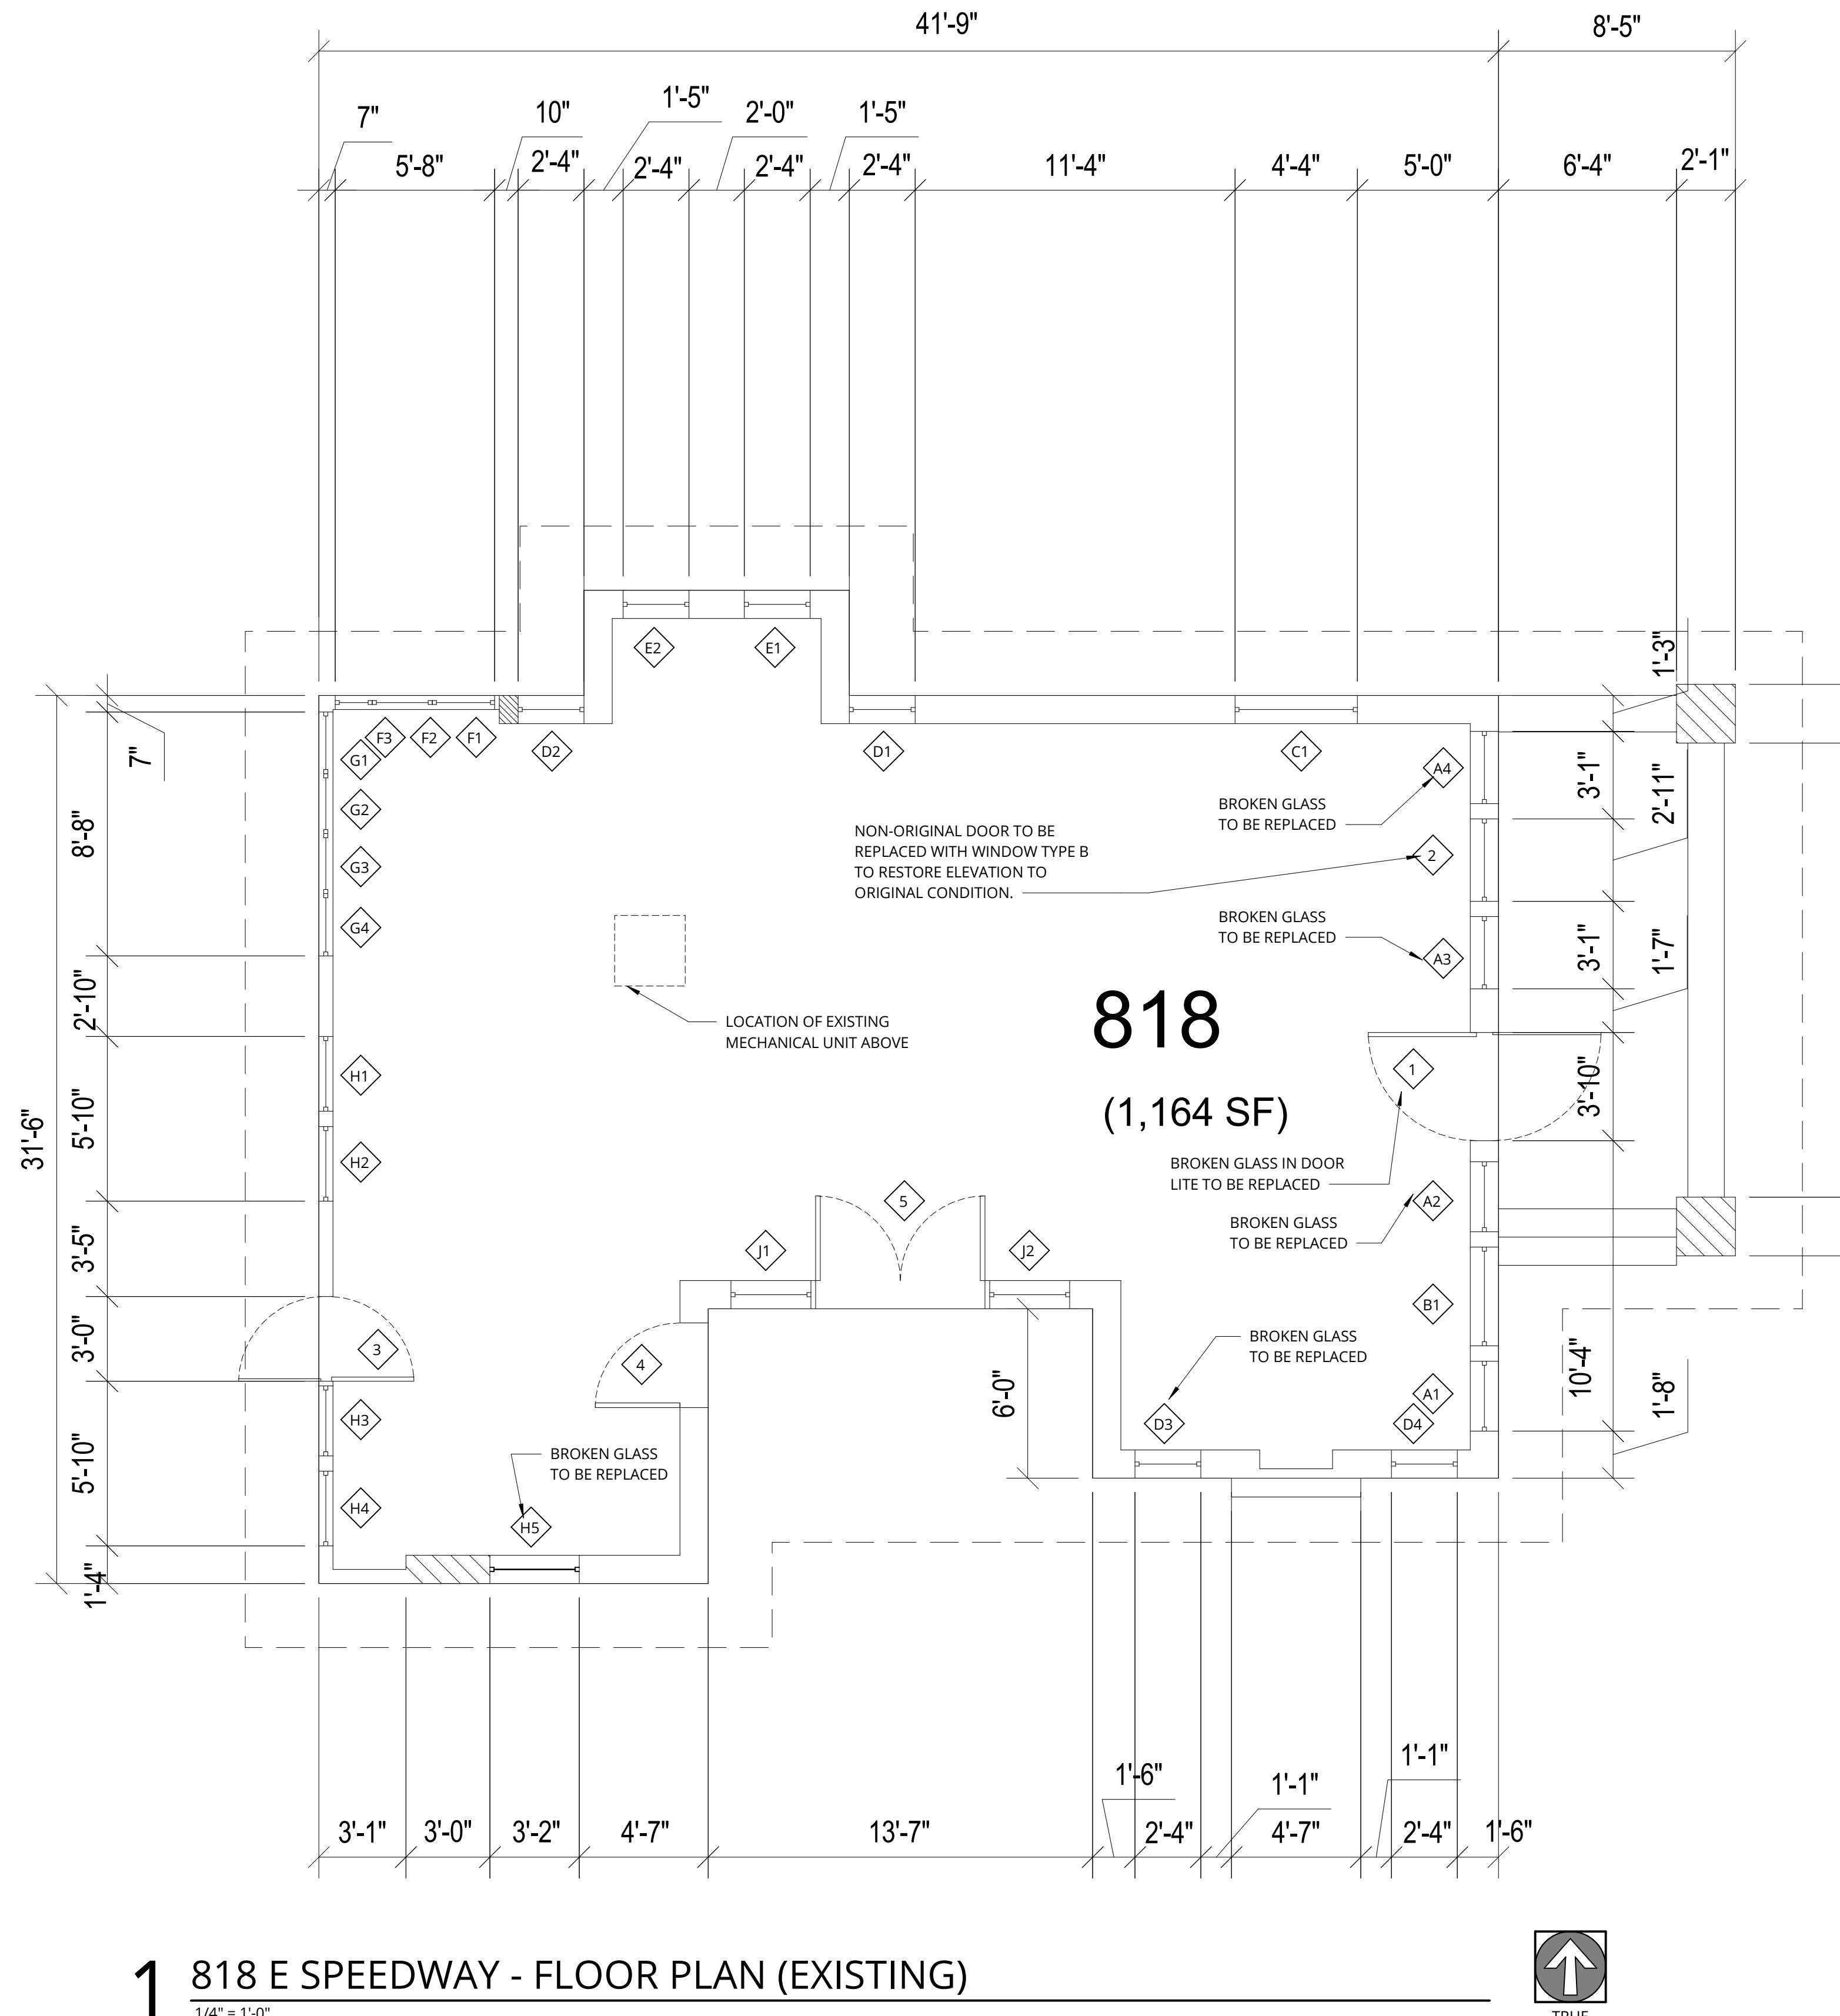

Zoning Approval
Building Plan
LShamis1
11/10/2025
PLANNING & DEVELOPMENT SERVICES

HR-2: Relocate historic home from
818 E Speedway Blvd to 925 N
Jacobs Ave. TD-DEV-0723-00304
SD-0624-00061.



Approved - Historic
Desiree
Aranda
Date: 11/14/2025
Case #
Permit #



REVIEWED FOR
BUILDING CODE
COMPLIANCE
K. Van Karsen
11/10/2025
CITY OF
TUCSON
PLANNING AND DEVELOPMENT SERVICES

DOOR SCHEDULE										
NO.	DESCRIPTION	SIZE			TYPE	MATERIAL	FINISH	COLOR	GLAZING	COMMENTS
		WIDTH	HEIGHT	TYPE						
1	FRONT DOOR	3'-10"	6'-8"	PANEL	WOOD	PAINTED		Y	1, 2, 3	
2	FRONT DOOR	2'-11"	6'-8"	PANEL	WOOD	PAINTED		Y	5	
3	BACK DOOR	3'-0"	6'-8"	PANEL	WOOD	PAINTED				
4	SIDE PORCH DOOR	3'-0"	6'-8"	FULL GLAZED	WOOD	PAINTED		Y	1, 2, 3	
5	SIDE PORCH DOOR (PAIR)	(2) 3'-0"	6'-8"	FULL GLAZED	WOOD	PAINTED		Y	1, 2, 3	


COMMENTS LEGEND

- 1 SCRAPE, SAND, PRIME AND PAINT DOOR
- 2 EXISTING HARDWARE TO BE RE-USED AND RE-KEYED.
- 3 EXISTING DOOR TO REMAIN
- 4 NEW DOOR
- 5 EXISTING DOOR TO BE REMOVED AND WINDOW ADDED TO RESTORE ELEVATION TO ORIGINAL CONDITION

WINDOW SCHEDULE										
MARK	DESCRIPTION	SIZE			TYPE	MATERIAL	FINISH	QTY	REPAIRS NEEDED Y/N	COMMENTS
		WIDTH	HEIGHT	TYPE						
A	SINGLE	2'-4"	4'-0"	DOUBLE HUNG	WOOD	PAINTED	4	Y	1, 2	
B	SINGLE	3'-6"	4'-0"	DOUBLE HUNG	WOOD	PAINTED	1	Y	1, 2	
C	SINGLE	4'-0"	4'-0"	DOUBLE HUNG	WOOD	PAINTED	1	Y	1, 2	
D	SINGLE	2'-0"	3'-0"	DOUBLE HUNG	WOOD	PAINTED	4	Y	1, 2	
E	SINGLE	2'-0"	3'-6"	DOUBLE HUNG	WOOD	PAINTED	2	Y	1, 2	
F	SINGLE	2'-0"	4'-2"	DOUBLE HUNG	WOOD	PAINTED	3	Y	1, 2	
G	SINGLE	2'-0"	4'-2"	DOUBLE HUNG	WOOD	PAINTED	4	Y	1, 2	
H	SINGLE	2'-6"	3'-2"	DOUBLE HUNG	WOOD	PAINTED	5	Y	1, 2	
J	SINGLE	3'-0"	6'-8"	FIXED	WOOD	PAINTED	2	Y	1, 2	

COMMENT LEGEND

- 1 SCRAPE, SAND, PRIME AND PAINT EXISTING WINDOWS TO REMAIN.
- 2 ALL WINDOWS TO BE BOARDED WITH 1/2" OSB FOR MOVE.
- 3 EXISTING AC UNIT TO BE DEMOLISHED AND WINDOW RESTORED TO ORIGINAL CONDITION
- 4 SEE PLANS AND ELEVATIONS FOR SPECIFIC WINDOW IDENTIFIERS.
- 5 ANY NEW OR REPLACEMENT WINDOWS TO BE KOLBE HERITAGE SERIES OR APPROVED EQUAL. MATCH EXISTING SIZE, OPERATION, DETAIL, AND COLORING.

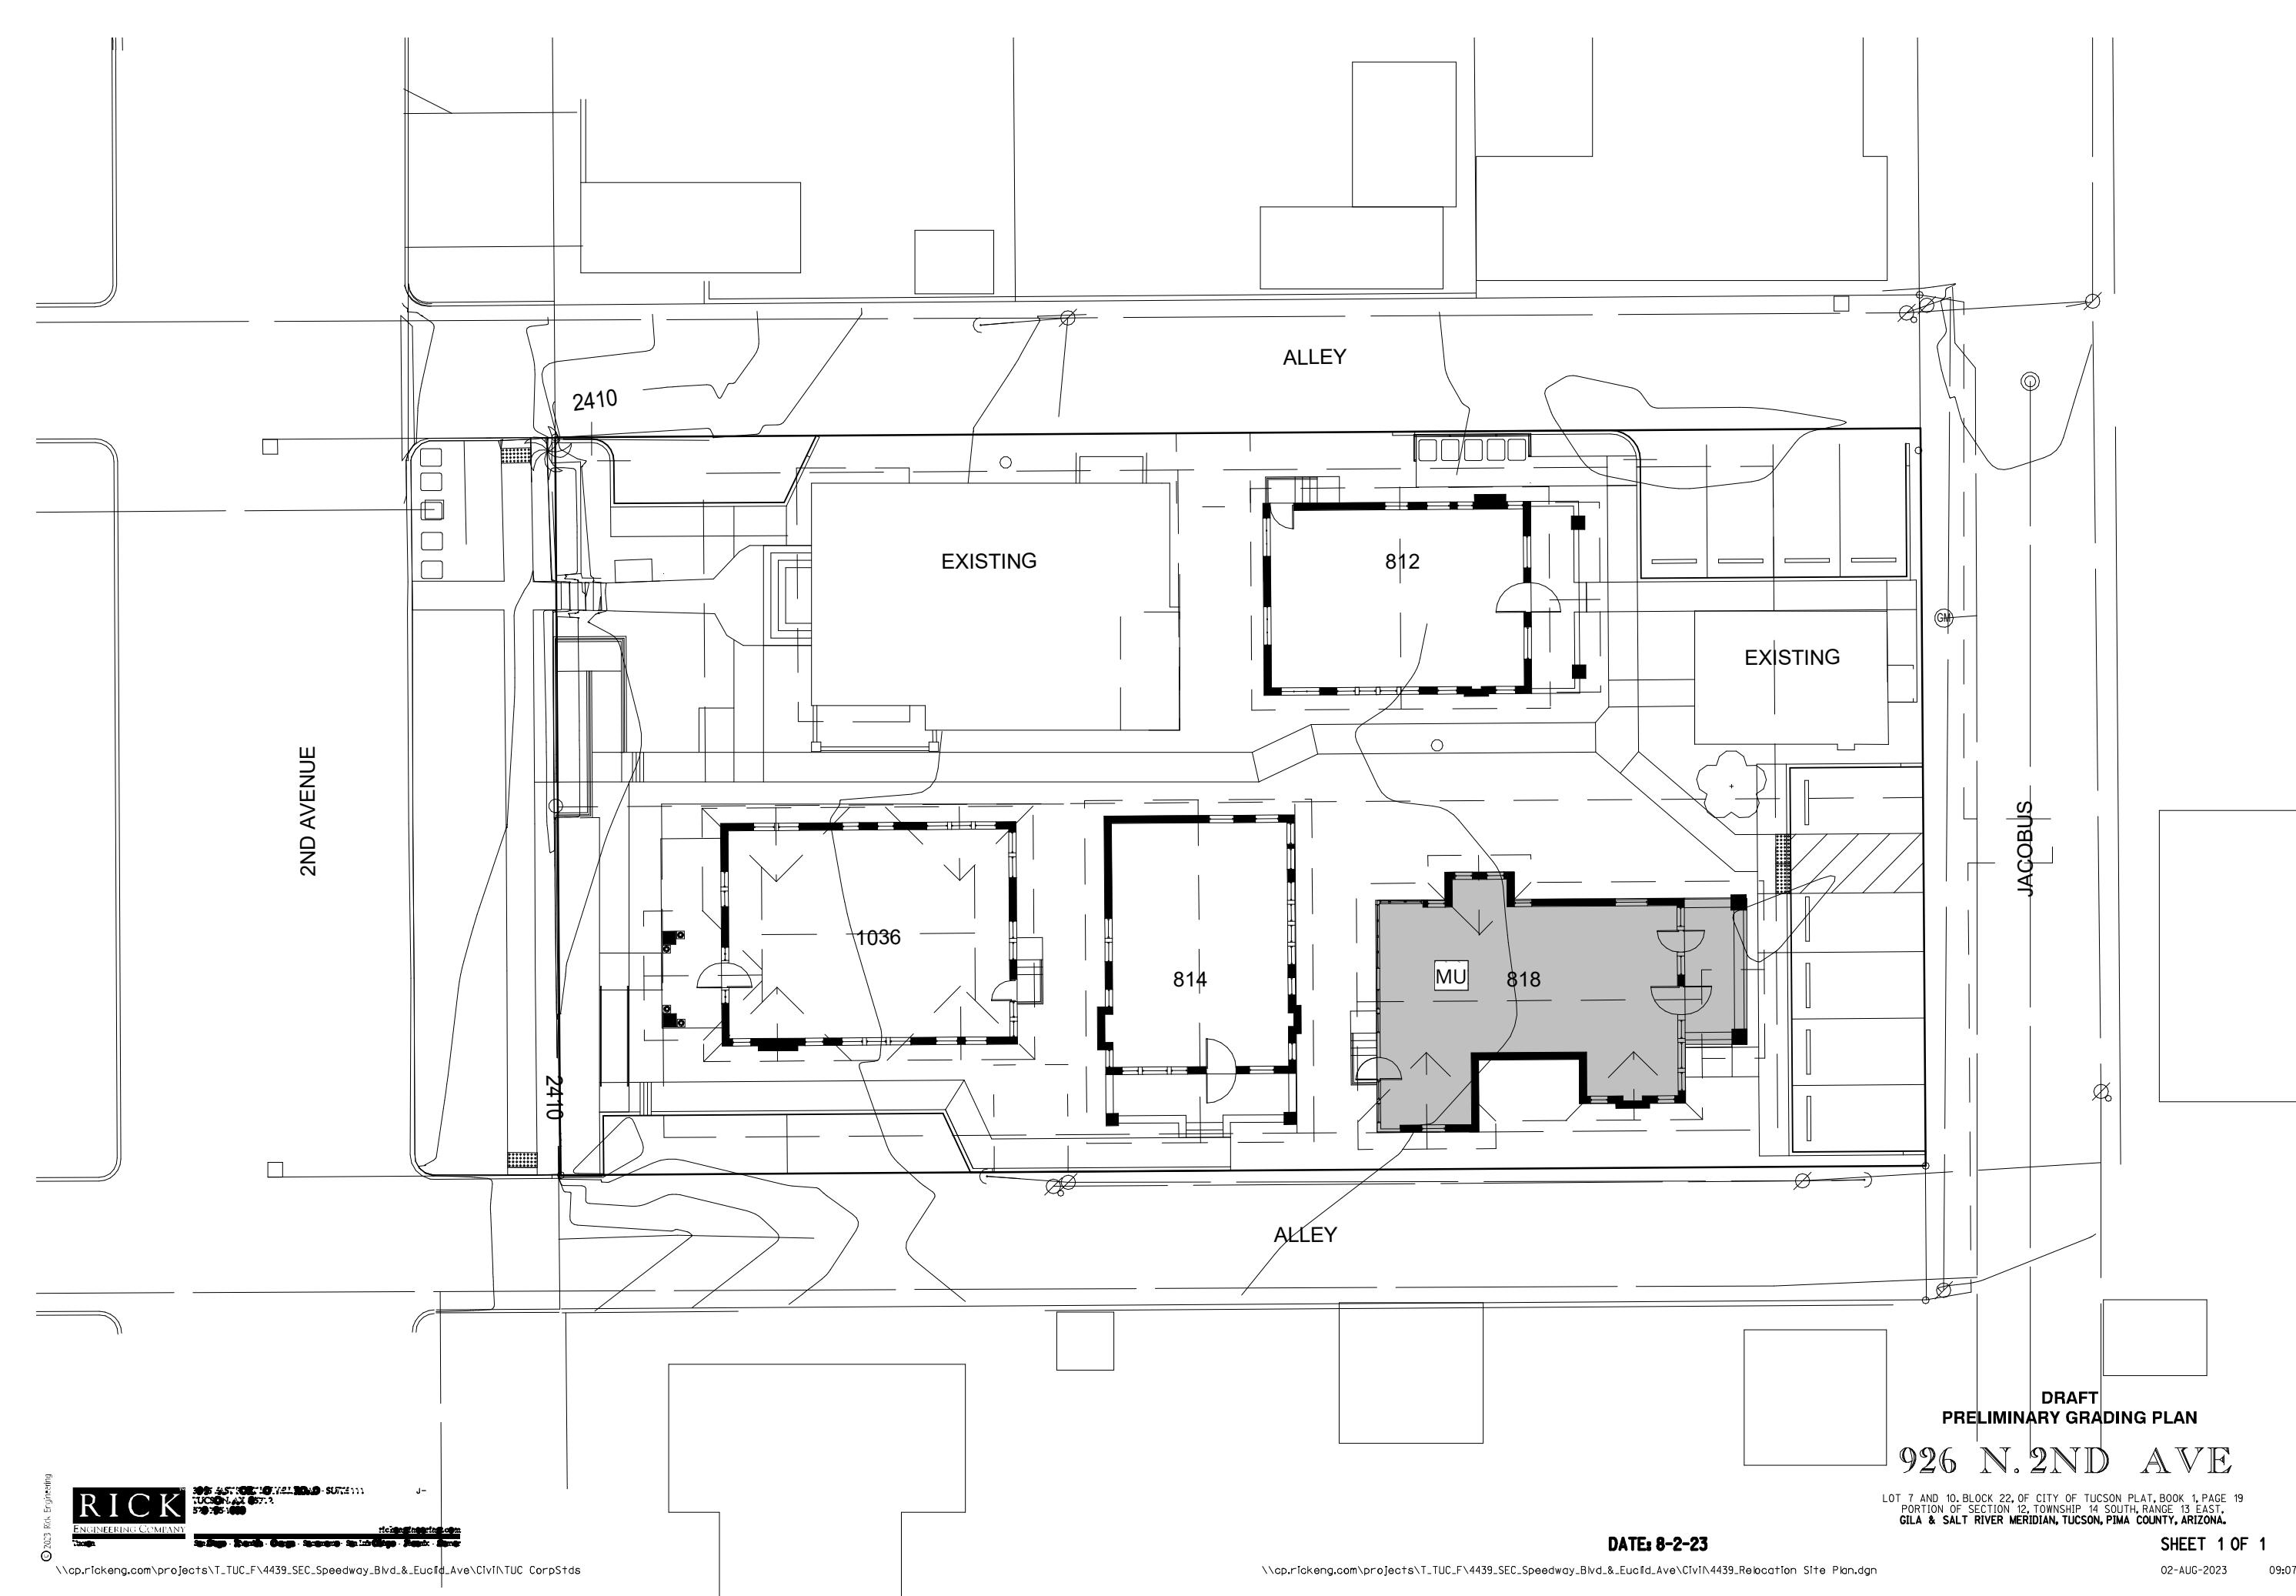

3 KEY PLAN - NEW LOCATION - 818 E SPEEDWAY



EAST ELEVATION (FORMERLY NORTH ELEVATION)

EAVES, RAKES AND RAFTER TAILS TO BE SCRAPED, Sanded, PRIMED, AND PAINTED.

CLUSTERED PORCH POSTS TO BE SALVAGED AND RE-INSTALLED.

COBBLESTONE COLUMN TO BE DECONSTRUCTED, SALVAGED AND RE-INSTALLED AT NEW LOCATION.

PARTIAL HEIGHT COBBLESTONE PORCH WALL TO BE DECONSTRUCTED, SALVAGED AND RECONSTRUCTED AT NEW LOCATION.



EAST ELEVATION (FORMERLY NORTH ELEVATION)



EAST ELEVATION (FORMERLY NORTH ELEVATION)

BROKEN GLASS TO BE REPLACED. SEE PLANS AND WINDOW SCHEDULE FOR LOCATIONS.

ORIGINAL ENTRY DOOR TO BE SCRAPED, Sanded, PRIMED, AND PAINTED. BROKEN GLASS TO BE REPLACED IN DOOR LITE.

DOOR TRIM TO BE REMOVED AS NEEDED AND RESTORED TO NEW CONDITION.

STUCCO FINISH TO BE PATCHED, TEXTURED AND PAINTED TO MATCH ADJACENT WALL.

NEW CONCRETE FLOOR SLAB TO MATCH EXISTING FOR COLOR, TEXTURE AND SCORING PATTERN.




EAST ELEVATION (FORMERLY NORTH ELEVATION)

BROKEN GLASS TO BE REPLACED. SEE PLANS AND WINDOW SCHEDULE FOR LOCATIONS.

NON-ORIGINAL DOOR TO BE DEMOLISHED AND REPLACED WITH WINDOW TO RESTORE ORIGINAL CONDITION. SEE ELEVATIONS.

PARTIAL HEIGHT COBBLESTONE PORCH WALL TO BE DECONSTRUCTED, SALVAGED AND RECONSTRUCTED AT NEW LOCATION.

NEW CONCRETE FLOOR SLAB TO MATCH EXISTING FOR COLOR, TEXTURE AND SCORING PATTERN.

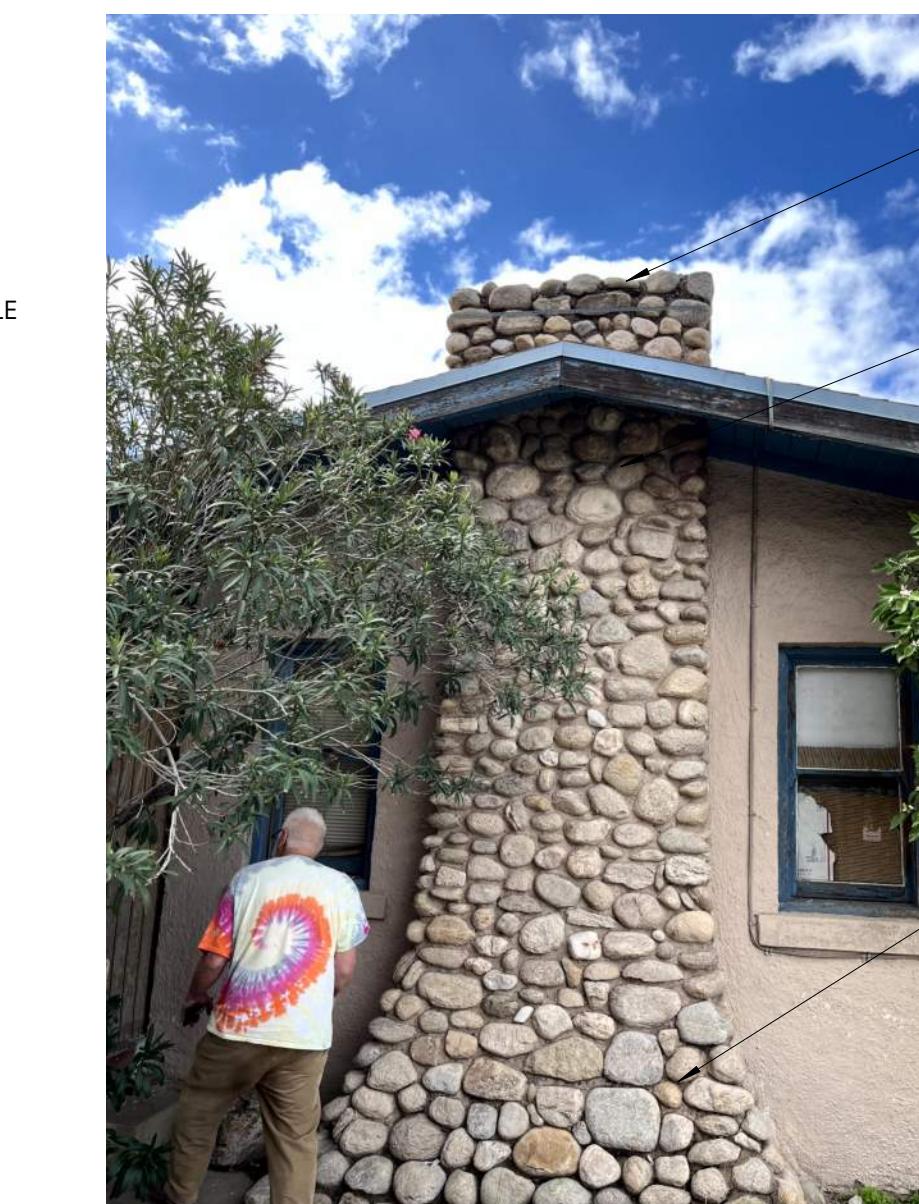

SOUTH ELEVATION (FORMERLY EAST ELEVATION)

PRIMARY COBBLESTONE CHIMNEY TO BE DECONSTRUCTED, SALVAGED AND RE-BUILT AT NEW LOCATION.

EAVES, RAKES AND RAFTER TAILS TO BE SCRAPED, Sanded, PRIMED, AND PAINTED.

PRIMARY COBBLESTONE CHIMNEY TO BE DECONSTRUCTED, SALVAGED AND RE-BUILT AT NEW LOCATION.



SOUTH ELEVATION (FORMERLY EAST ELEVATION)

WINDOWS FRAMES TO BE SCRAPED, Sanded, PRIMED, AND PAINTED. SEE WINDOW SCHEDULE FOR MORE INFORMATION.

EXISTING UTILITIES TO BE DEMOLISHED. PATCH STUCCO FINISH AS REQUIRED TO MATCH EXISTING ADJACENT WALL.

PRIMARY COBBLESTONE CHIMNEY TO BE DECONSTRUCTED, SALVAGED AND RE-BUILT AT NEW LOCATION.

STUCCO FINISH TO BE PATCHED, TEXTURED AND PAINTED TO MATCH ADJACENT WALL.




SOUTH ELEVATION (FORMERLY EAST ELEVATION)

EXISTING WOOD SIDING TO BE SCRAPED, Sanded, PRIMED, AND PAINTED.


WINDOW MOUNTED AC UNIT TO BE REMOVED.

STUCCO FINISH TO BE PATCHED, TEXTURED AND PAINTED TO MATCH ADJACENT WALL.

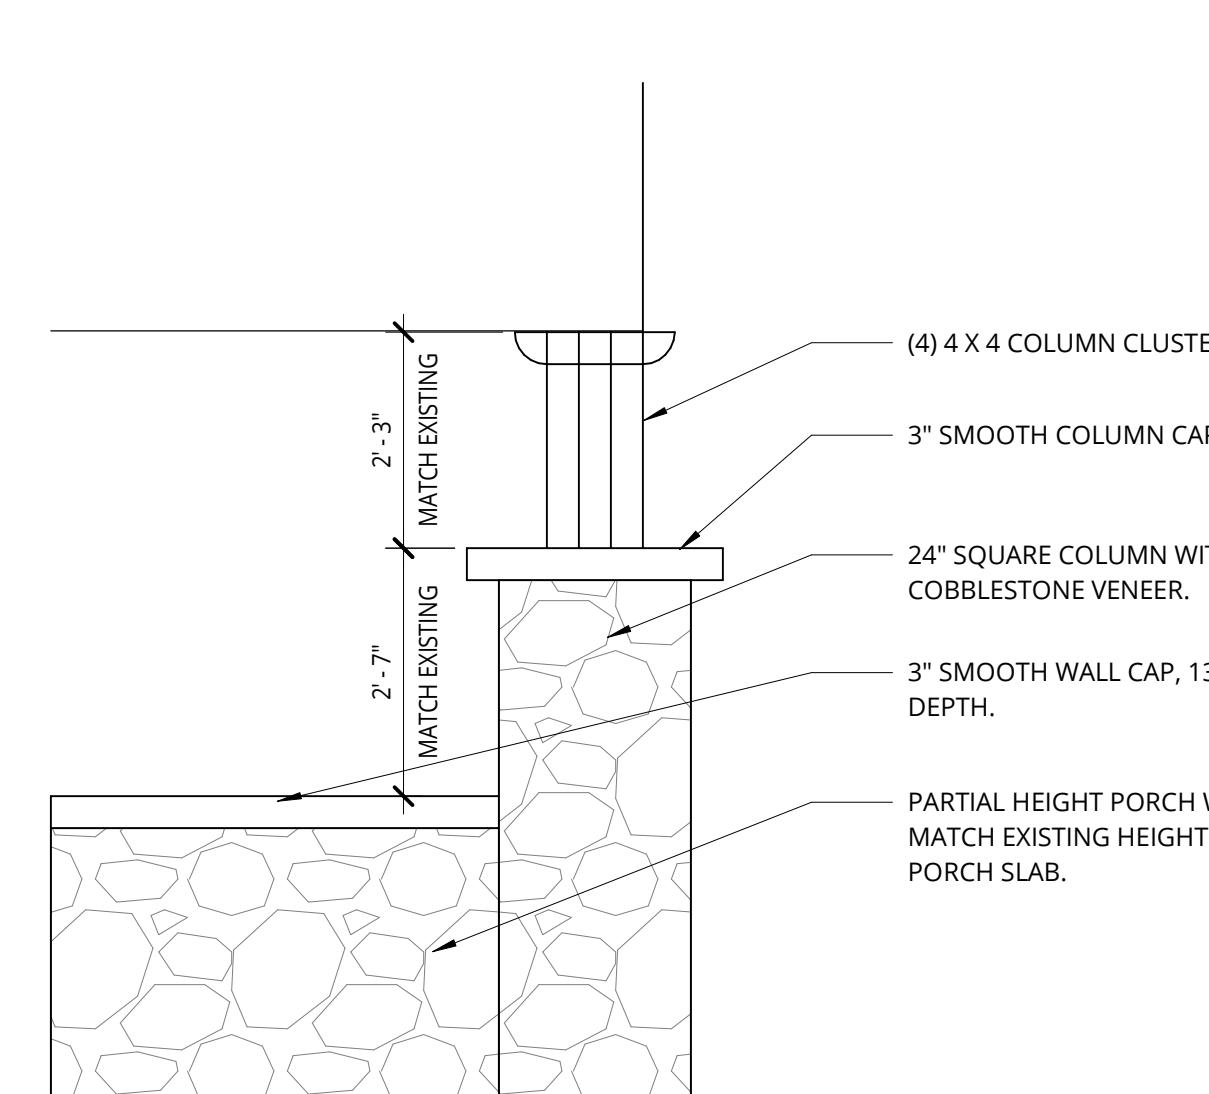

1 COLUMN DETAIL - 818

1/2" = 1'-0"

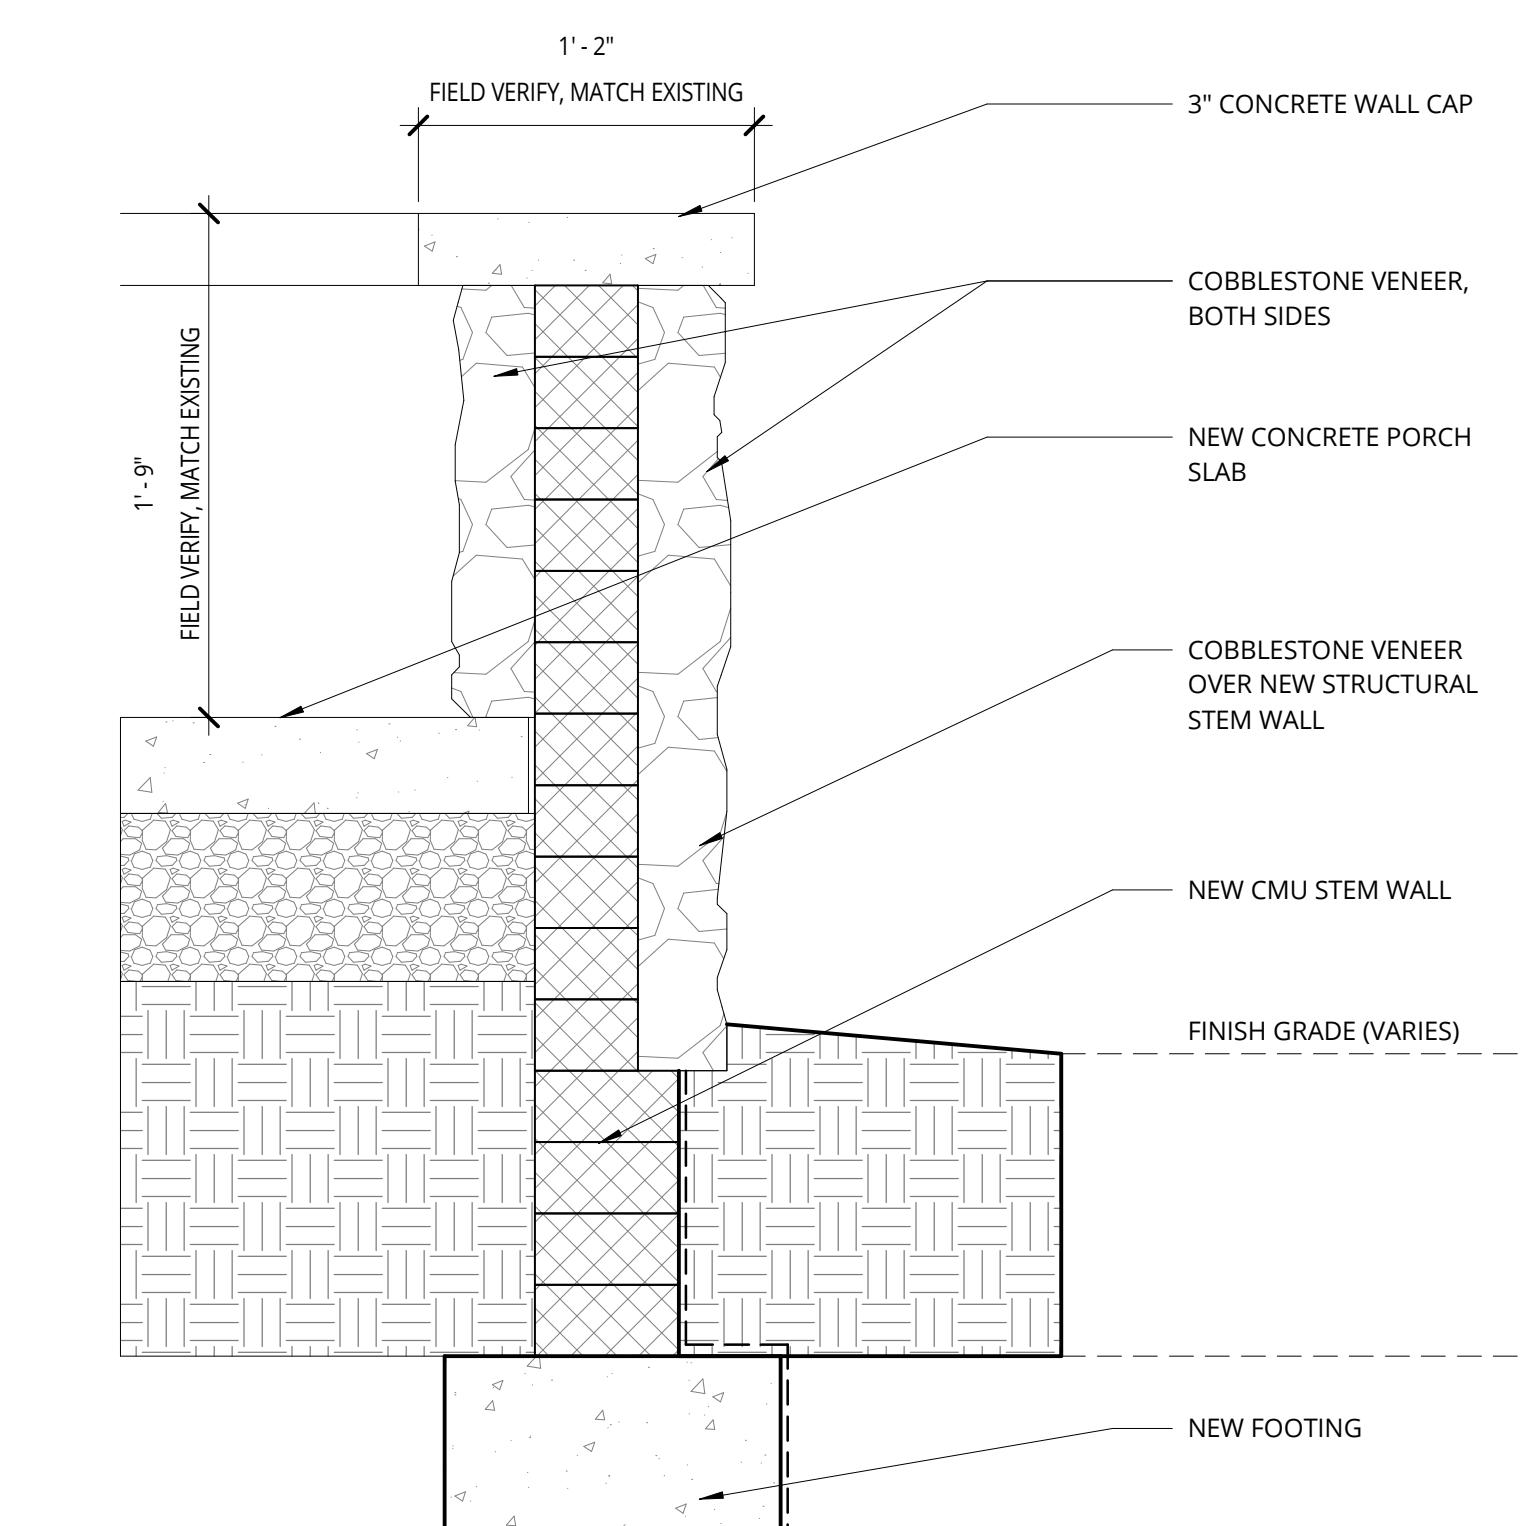

2 PORCH WALL DETAIL - 818

1/2" = 1'-0"

TUCSON SPEEDWAY HISTORICAL HOUSES RELOCATION

Capstone Collegiate Communities/JSC LLC

Tucson, AZ

REVISION	DATE	REASON FOR ISSUE

818 - DETAILS

CONCEPT DESIGN

DATE	PROJECT NUMBER
04/09/2024	184170

SHEET NUMBER

184170

A7.24

Approved - Historic
Date: 11/14/2025
Desree
Aranda
Case #
Permit #REVIEWED FOR
BUILDING CODE
COMPLIANCE
K. Van Karsen
11/10/2025
CITY OF TUCSON
PLANNING AND DEVELOPMENT SERVICES