



3036 East Greenway Rd.
Phoenix, AZ 85032

T 602.494.0800

January 27, 2026

Re: Tucson Speedway Historical Houses Relocation
926 N 2nd Ave, Tucson, AZ 85719
CORE Job No. 24-02-006

Dear Desiree Aranda,

This correspondence is submitted to document final roof color selections for the subject properties and to request review of limited exterior material and window modifications for House 818 only, as discussed during our on-site walk conducted on January 22, 2026.

Roof Color Selections (Roof Only)

The previously specified roof colors are no longer available due to product discontinuation or regional supply limitations. As a result, alternative roof colors were selected that closely align with the originally approved intent. These selections apply exclusively to roofing materials and do not represent final exterior wall or façade colors.

The final roof-only color selections are as follows:

- **House 1040-1042:** Pewter Gray
- **House 1036:** Barkwood
- **House 814:** Barkwood
- **House 818:** Pewter Gray
- **House 812:** Pewter Gray

Requested Modifications – House 818 Only

Per the January 22, 2026 site walk, portions of the north elevation, a small section of the south elevation, and the west elevation of House 818 were originally shown to retain existing wood siding. Based on site observations, the existing wood siding in these areas was determined to be not salvageable due to severe water damage. As discussed onsite, these areas are proposed to be replaced with stucco to match the existing house, in order to maintain consistency and improve long-term durability.

As shown on the markup drawings, a revised window configuration is also proposed for House 818 to reflect the layout discussed during the site walk, while maintaining appropriate proportions and alignment consistent with the building's character.

Additionally, as shown on the markup drawings, the east elevation will remain unchanged. It was determined during the site walk that the second entry door on the east elevation is original, and therefore both entry doors are proposed to remain, with the original door to be repaired and restored. These requested changes are limited solely to House 818. No other properties or exterior elements are impacted beyond what is described herein.

We respectfully request your review and concurrence that the proposed roof color selections and House 818 exterior and window modifications, as described above and shown on the markup drawings, are acceptable and consistent with the City's historic preservation standards and applicable guidelines.

Respectfully,

Ross Valenzuela
Project Director
CORE Construction, Inc.
520.369.8679
rossvalenzuela@COREConstruction.com



www.coreconstruction.com
B-01 069786 ROC A-110343 ROC

CAPSTONE COLLEGIATE COMMUNITIES / JJSC LLC

EUCLID AND SPEEDWAY

HISTORICAL HOUSES RELOCATION PROJECT

NOT FOR CONSTRUCTION




38 NORTHWEST DAVIS, SUITE 300
PORTLAND, OR 97209
503.245.7100

1505 5TH AVE, SUITE 300
SEATTLE, WA 98101
206.576.1600

1014 HOWARD STREET
SAN FRANCISCO, CA 94103
415.252.7063

© ANKROM MOISAN ARCHITECTS, INC.

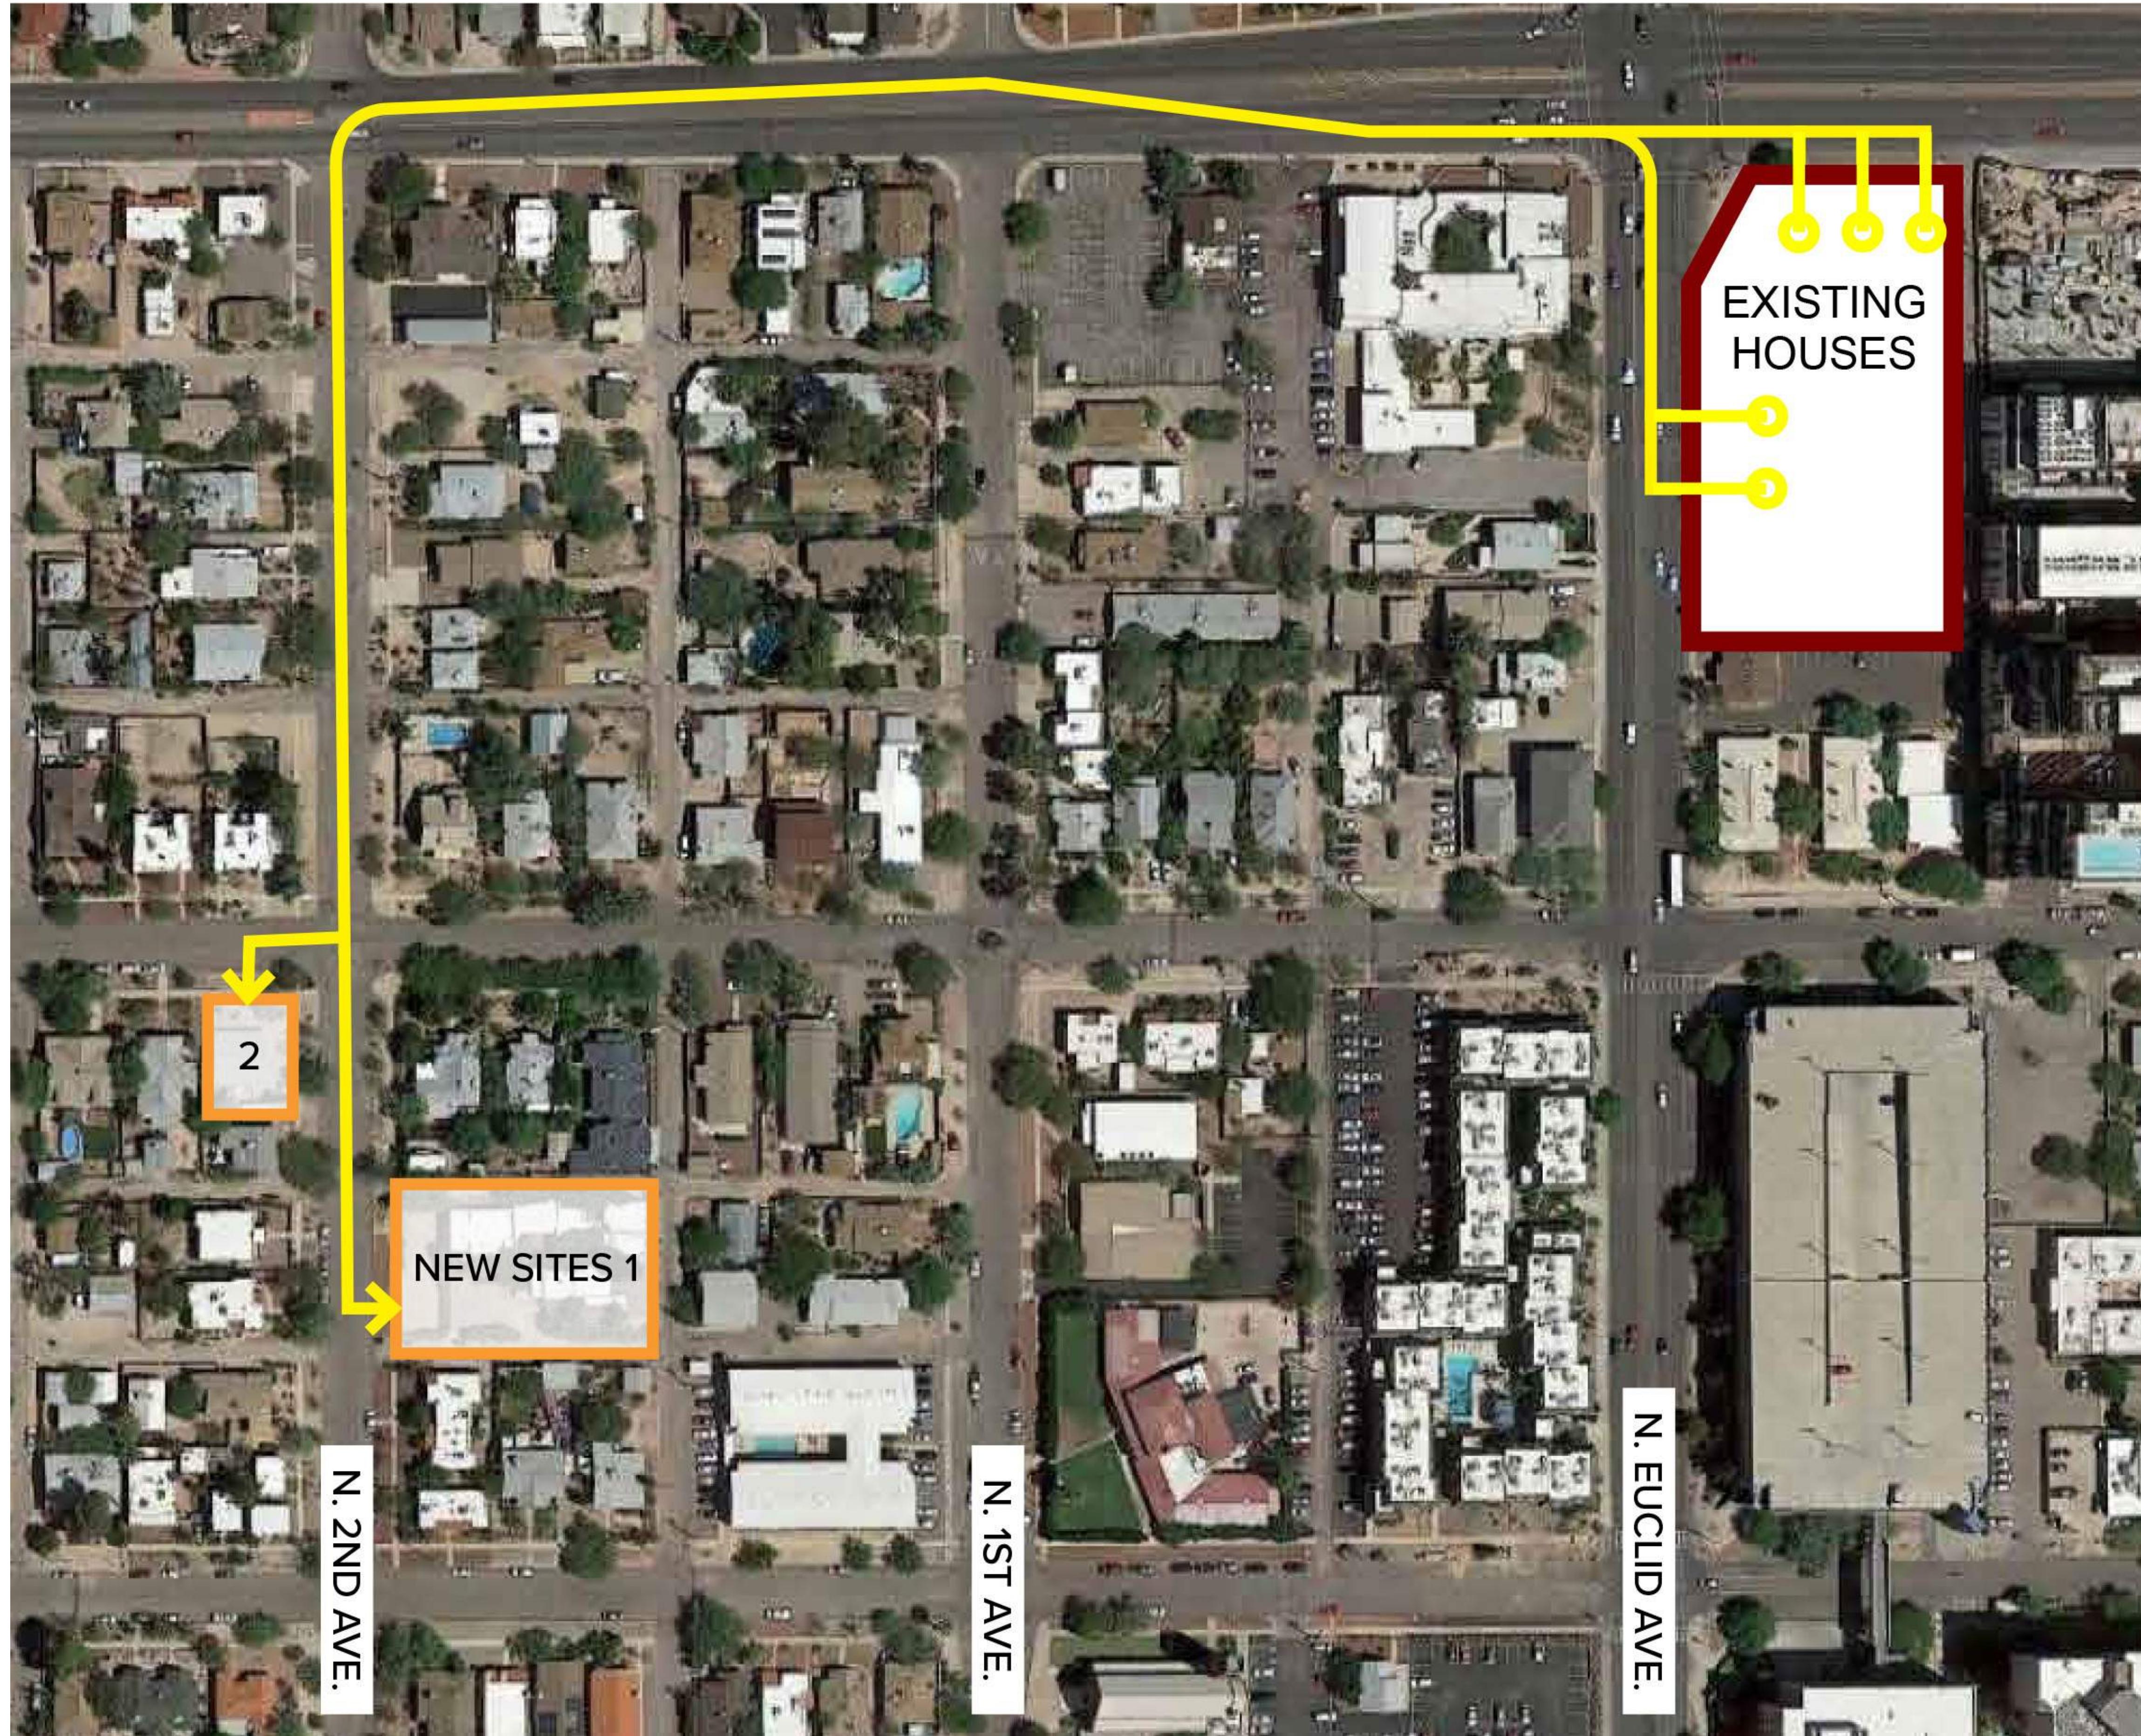GENERAL NOTES - RELOCATION**PROCEDURE FOR RELOCATION**

THE PROCESS OF MOVING WILL BE ACCOMPLISHED IN A SEQUENCE BASED ON THE NEW LOCATIONS FOR EACH HOUSE (TO BE DETERMINED).

THE INITIAL STEP REQUIRES MINOR EXCAVATION AND GRADING AROUND EACH HOUSE TO FACILITATE ACCESS FOR PLACING STEEL I-BEAMS UNDER THE HOUSE. NOTCHES WILL BE CUT IN THE STEM WALLS TO ALLOW FOR THE INSERTION OF STEEL BEAMS. THE BEAMS ARE THEN SUPPORTED BY A SECOND SET OF BEAMS THAT ARE FASTENED TOGETHER TO CREATE A SOLID PLATFORM BASE UNDER EACH HOUSE. THE HOUSES WILL BE LIFTED FROM BELOW AT THE BASE OF THE MAIN SILL PLATE AND FLOOR JOINTS, SHIMMED AS REQUIRED. THE STEEL PLATFORM BASE IS THEN LIFTED AND ATTACHED TO A TRUCK FOR THE ACTUAL MOVE. IN CASES WHERE THERE IS A VENEER OF TUFAS OR COBBLESTONE, THIS WILL BE REMOVED, OR IF THE STEM WALL IS STRUCTURAL, THE TUFAS OR COBBLESTONE STEM WALL WILL BE DISASSEMBLED AND RELOCATED.

AS NOTED BELOW, IN SOME CASES THE PORCH ROOFS WILL BE REMOVED FROM THE "MAIN BLOCK" OF THE HOUSE AND THE MATERIALS SALVAGED FOR POTENTIAL REUSE. IN OTHER CASES, THE PORCHES ARE INTEGRAL TO THE PREDOMINANT ROOF STRUCTURE AND WILL BE SUPPORTED WITH STEEL BRACING INTEGRATED WITH THE STEEL BASE.

NON-HISTORIC ADDITIONS WILL BE REMOVED AND THOSE WALL SECTIONS RESTORED TO THEIR ORIGINAL APPEARANCE AS PART OF THE REHABILITATION.

MOVE ROUTE

IN GENERAL, THE HOUSES WILL BE TOWED FROM THEIR CURRENT SITE ONTO EITHER SPEEDWAY OR EUCLID AND MANEUVERED TO PROCEED WEST ON SPEEDWAY. THIS WILL REQUIRE TEMPORARY BLOCKING OF TRAFFIC AND LIKELY TEMPORARY RELOCATION OF STREETLIGHTS. THE ROUTE WILL TURN SOUTH ON SECOND AVENUE FOR TWO BLOCKS BEFORE ARRIVING AT THE NEW SITE. SOME TRIMMING OF TREES WILL BE REQUIRED, AS WELL AS ALL CARS PROHIBITED FROM PARKING ON THE STREET. THE MOVES ARE EXPECTED TO OCCUR OVERNIGHT, OVER A FIVE-WEEK PERIOD. THE EXACT SCHEDULE WILL BE DETERMINED VIA CITY ROW USE PERMIT PROCESS.

PREPARATION WORK FOR NEW LOCATION

NEW FOOTINGS WILL BE CONSTRUCTED PRIOR TO THE MOVE. FOUNDATIONS/STEM WALLS WILL THEN BE BUILT UP TO THE BASE OF EACH HOUSE SO THEY CAN BE SET IN PLACE. FOUNDATION SHEATHING WILL OCCUR AS PART OF THE REHABILITATION, AS NOTED BELOW. AT THE 928 N. SECOND AVENUE SITE, AN EXISTING RETAINING WALL WILL NEED TO BE REMOVED AND THE LAND GRADED TO ALLOW ACCESS FOR THE HOUSES. THE SITE WILL NEED TO BE REGRADED, STABILIZED AND COMPACTED. THE RETAINING WALL WILL NEED TO BE RECONSTRUCTED. SPECIFICS ON WORK REQUIRED FOR THE MOVE OF EACH HOUSE ARE OUTLINED IN THE COMING PAGES.

EXTERIOR REHABILITATION OF HOUSES

THE MOVE PROCEDURE WILL REQUIRE REMOVAL OF CERTAIN FEATURES, NOTABLY PORCHES AND OTHER PROJECTIONS, THAT ARE NOT INTEGRAL TO THE STRUCTURAL FRAME OF THE HOUSE.

THERE ARE ALSO CERTAIN GENERAL CONDITIONS PERTAINING TO THE MOVE PROCEDURE. WINDOWS SHALL BE CONSIDERED TO BE PART OF THE PRIMARY STRUCTURE AND WILL BE MOVED AS PART OF THE MAIN BLOCK. THE WINDOWS WILL BE BOARDED WITH 1/2" OSB PRIOR TO THE MOVE FOR PROTECTION AND STABILITY. CRACKED OR BROKEN GLASS WILL BE REPLACED AS NEEDED AFTER THE MOVE. PORCH FLOORS AND STAIRS THAT ARE SCORED CONCRETE WILL NOT BE MOVED, BUT WILL BE REPLICATED TO MATCH THE ORIGINAL MATERIAL. ALL ROOFS WILL BE MOVED WITH THE HOUSE, BUT HOUSES MAY NEED NEW ROOF SHEATHING TO BE APPLIED AT THE NEW LOCATION. THE NEW SITE WILL BE FENCED FOR SECURITY, TYPICAL OF ANY CONSTRUCTION SITE.

SEE PLANS AND ELEVATIONS FOR THE SPECIFIC ARCHITECTURAL FEATURES OF THE HOUSES TO BE RESTORED/REPAIRED ON EACH HOUSE IN ORDER TO RETAIN THE INTEGRITY OF THE HISTORIC APPEARANCE.

SHEET INDEX

NUMBER	SHEET NAME	HP REVIEW
00 GENERAL		
G0.01	Sheet Index	<input checked="" type="checkbox"/>
A3.51	STREET ELEVATIONS	<input checked="" type="checkbox"/>

01 CIVIL

C101	SITE PLAN	<input checked="" type="checkbox"/>
------	-----------	-------------------------------------

02 LANDSCAPE

L01	LANDSCAPE GENERAL NOTES	<input checked="" type="checkbox"/>
L02	PLANTING PLAN	<input checked="" type="checkbox"/>
L03	PLANTING DETAILS	<input checked="" type="checkbox"/>
L04	IRRIGATION PLAN	<input checked="" type="checkbox"/>
L05	IRRIGATION DETAILS	<input checked="" type="checkbox"/>
L06	WATER HARVESTING PLAN	<input checked="" type="checkbox"/>

04 ARCHITECTURAL

A2.01	1036 - FLOOR PLANS AND SCHEDULES	<input checked="" type="checkbox"/>
A2.02	812 - FLOOR PLANS AND SCHEDULES	<input checked="" type="checkbox"/>
A2.03	814 - FLOOR PLANS AND SCHEDULES	<input checked="" type="checkbox"/>
A2.04	818 - FLOOR PLANS AND SCHEDULES	<input checked="" type="checkbox"/>
A3.01	1036 - RELO ELEVATIONS	<input checked="" type="checkbox"/>
A3.02	812 - RELO ELEVATIONS	<input checked="" type="checkbox"/>
A3.03	814 - RELO ELEVATIONS	<input checked="" type="checkbox"/>
A3.04	818 - RELO ELEVATIONS	<input checked="" type="checkbox"/>
A3.06	928 - EXISTING ELEVATIONS	<input checked="" type="checkbox"/>
A7.21	1036 - DETAILS	<input checked="" type="checkbox"/>
A7.22	812 - DETAILS	<input checked="" type="checkbox"/>
A7.22A	812 - DETAILS	<input checked="" type="checkbox"/>
A7.23	814 - DETAILS	<input checked="" type="checkbox"/>
A7.24	818 - DETAILS	<input checked="" type="checkbox"/>

05 CIVIL

C101a	SITE PLAN - 548	<input checked="" type="checkbox"/>
-------	-----------------	-------------------------------------

06 LANDSCAPE

L01a	LANDSCAPE PLAN - 548	<input checked="" type="checkbox"/>
------	----------------------	-------------------------------------

07 ARCHITECTURAL

A2.05	1040-1042 - FLOOR PLANS AND SCHEDULES	<input checked="" type="checkbox"/>
A3.05	1040-1042 - RELO ELEVATIONS	<input checked="" type="checkbox"/>
A7.25	1040-1042 - DETAILS	<input checked="" type="checkbox"/>

TUCSON SPEEDWAY HISTORICAL HOUSES RELOCATION

926 N. 2ND AVE.
TUCSON, AZ

Capstone Collegiate Communities/JJSC LLC


SHEET INDEX

DATE	REASON FOR ISSUE
04/09/2024	PROJECT NUMBER 184170
	SHEET NUMBER 184170

G0.01

LANDSCAPE BUFFERYARD TABLE

BUFFER	BORDER TYPE	WIDTH	BORDER LENGTH	BORDER AREA	TREES REQ'D	TREES PROVIDED	SHRUB COVERAGE REQ'D	SHRUB COVERAGE PROVIDED	SCREENING ELEMENT PROVIDED
2ND AVE.	STREET	10'	100 LF	1,000 SF	3	4	500 SF	500+ SF	30" VEGETATIVE SCREEN

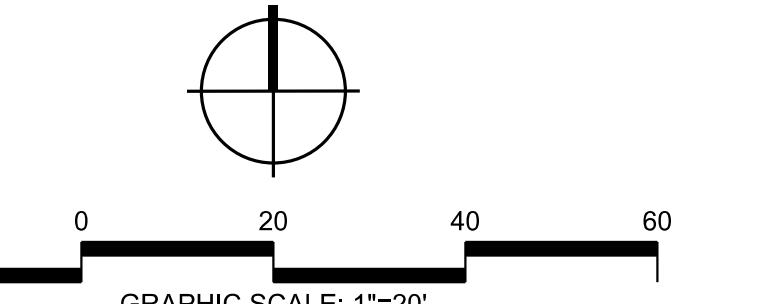


PLANT MATERIAL LEGEND

SYMBOL	BOTANICAL NAME COMMON NAME	QTY.	SIZE	H x W (CALIPER)
	ACACIA ANEURA MULGA ACACIA	4	15 GAL.	4" x 2" (.5")
	PROSOPIS VELUTINA VELVET MESQUITE	4	15 GAL.	5.5" x 3" (.5")

SHRUBS AND ACCENTS

	AOE x 'BLUE ELF' BLUE ELF ALOE	30	5 GAL.
	AGAVE OCAHUI OCAHUI AGAVE	13	5 GAL.
	ASCLEPIAS SUBULATA DESERT MILKWEED	3	5 GAL.
	CALLIANDRA ERIOPHYLLA FAIRY DUSTER	15	5 GAL.
	DALEA FRUTESCENS BLACK DALEA	6	5 GAL.
	DALEA GREGGII TRAILING INDIGO BUSH	5	5 GAL.
	DASYLIRION WHEELERI DESERT SPOON	2	5 GAL.
	ENCELIA FARINOSA BRITTLE BUSH	16	5 GAL.
	EUPHORIA ANTISYPHILITICA CANDELILLA	5	5 GAL.
	FEROCACTUS WISLizenii BARREL CACTUS	5	5 GAL.
	HESPERALOE PARVIFLORA RED YUCCA	4	5 GAL.

USA STAMP TO BE
WPA PRESERVED

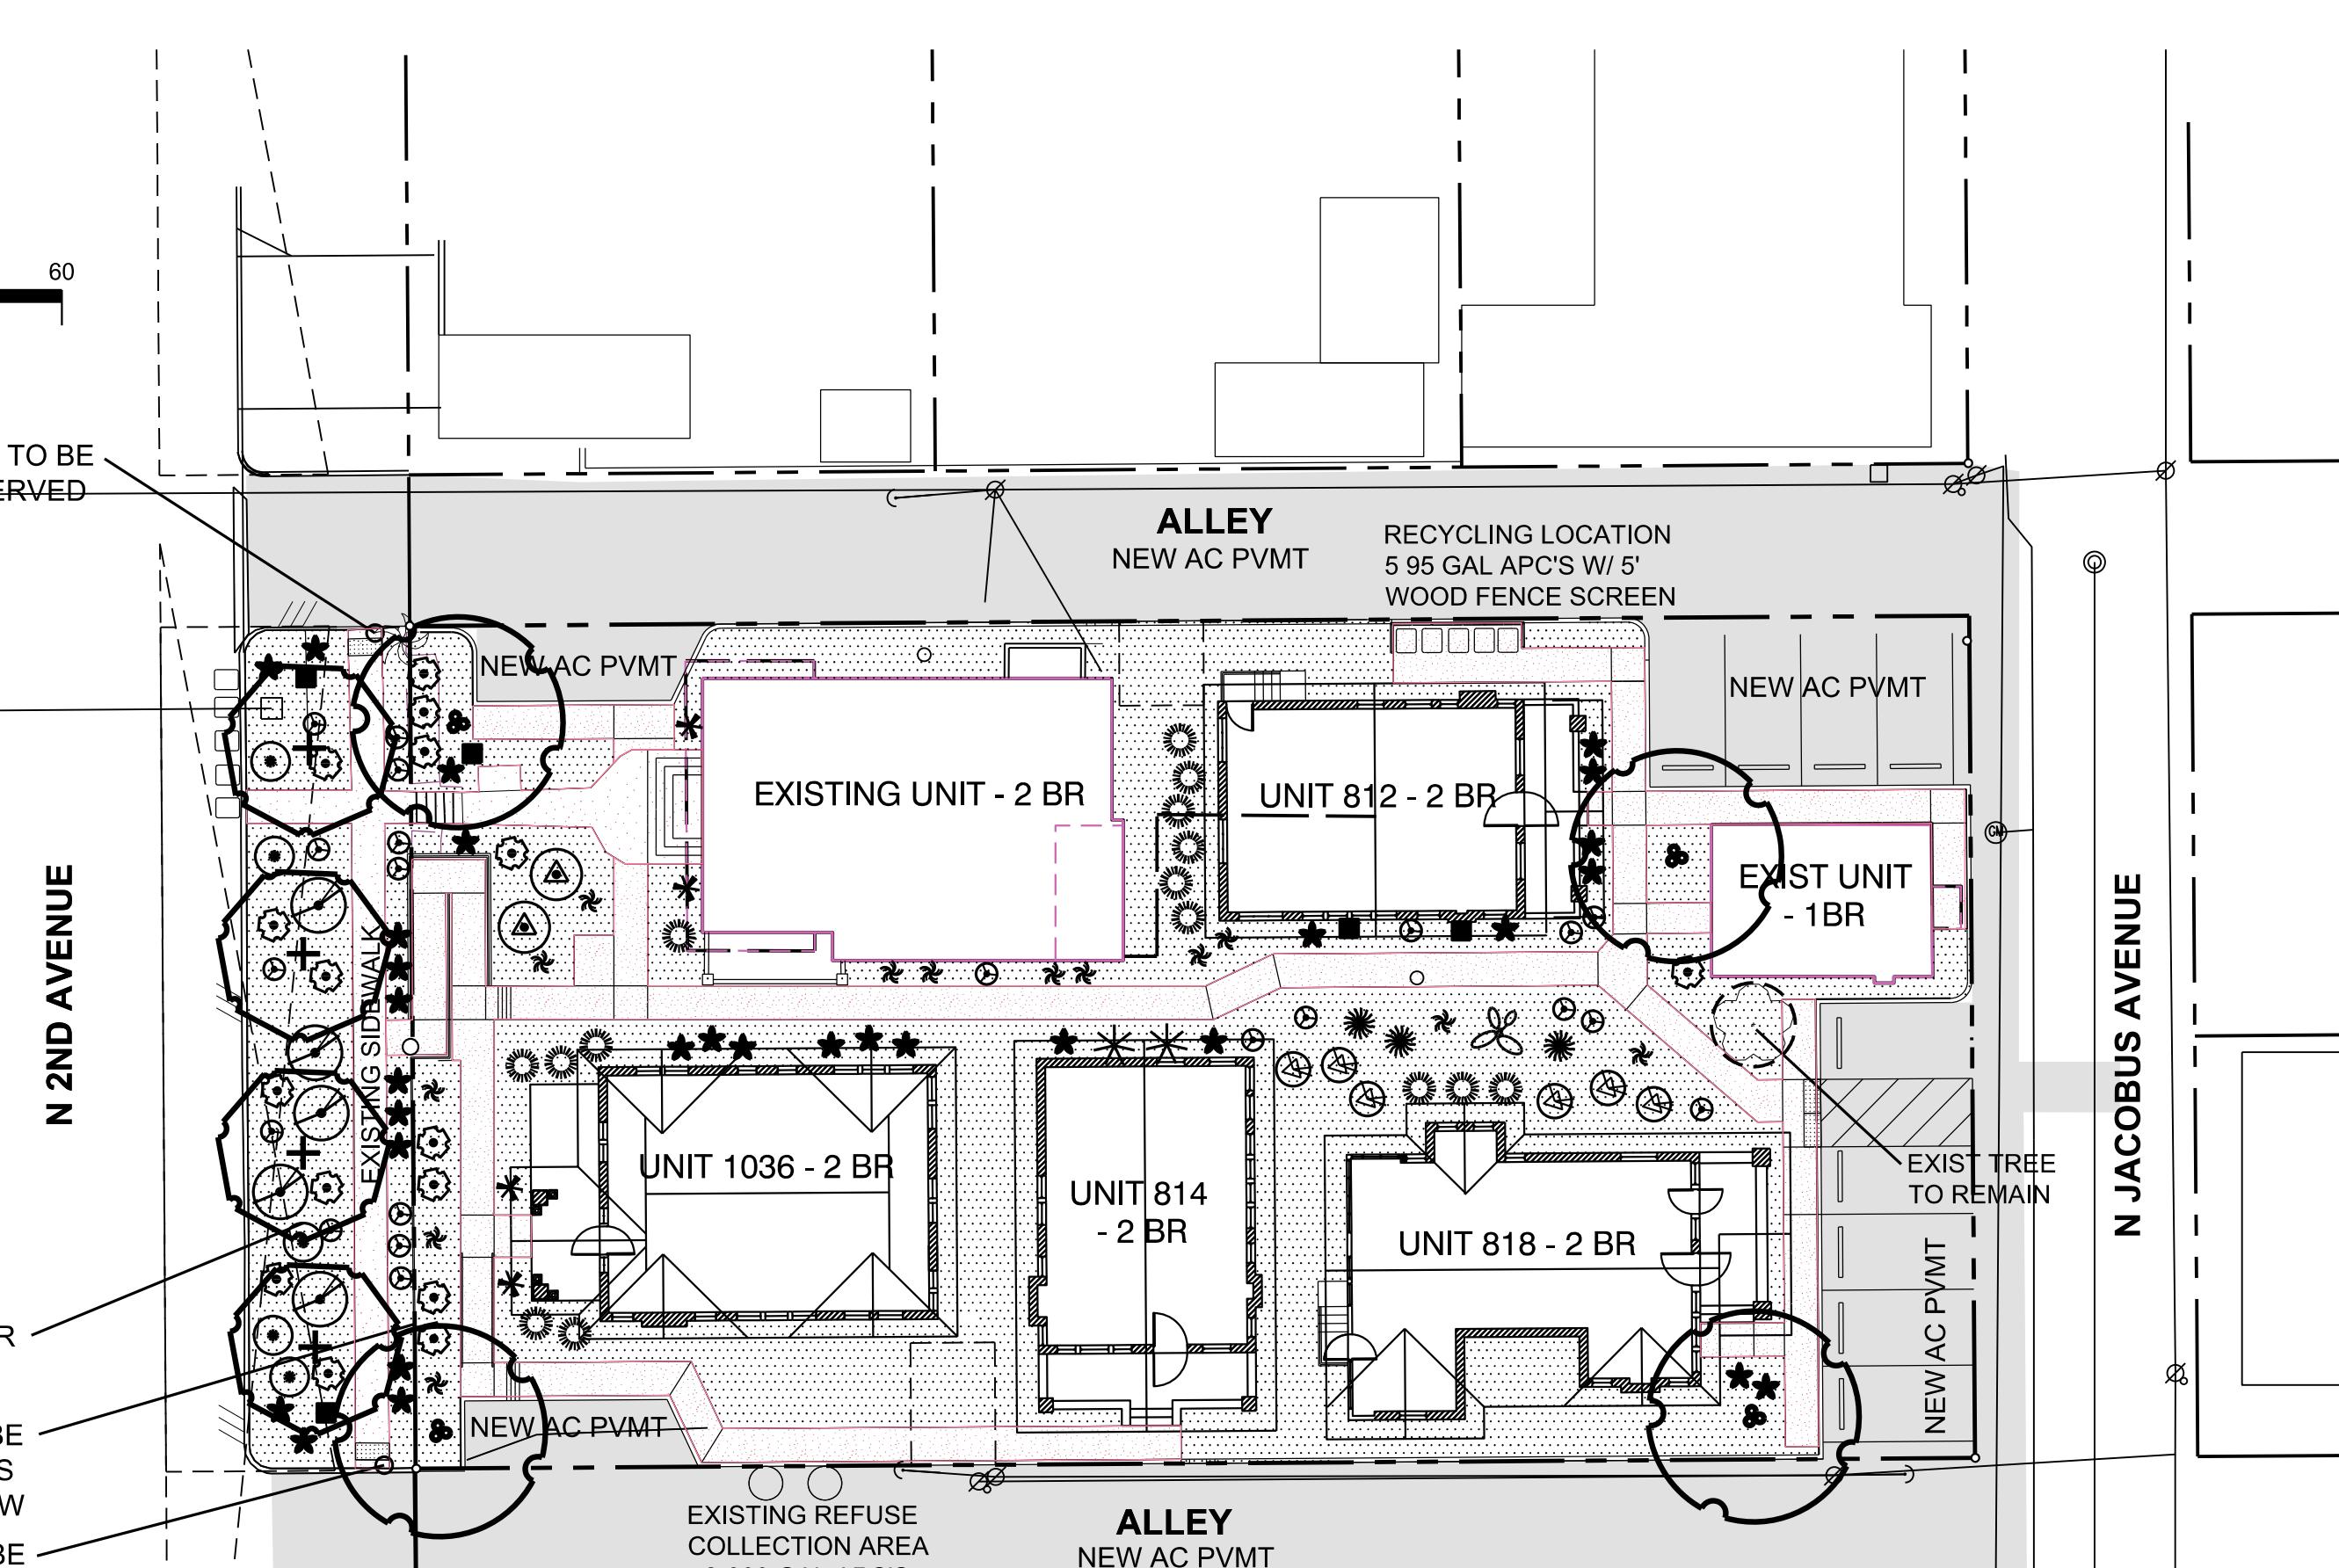

N 2ND AVENUE

N JACOBUS AVENUE


PRELIMINARY

rickengineering.com
J-4439-A
3945 EAST FORTLOWELL ROAD - SUITE 111
TUCSON, AZ 85712
520-795-0000

rickengineering.com
San Diego, Riverside, Orange, Santa Clara, San Luis Obispo, Sacramento, Phoenix, Las Vegas, Denver
Tucson

RICK
ENGINEERING COMPANY
Tucson
DESIGNED BY: TCM DATE: 5/2024 CHECKED BY: TCM DATE: 5/2024 APPROVED BY: TCM DATE: 5/2024 DRAWN BY: TCM DATE: 5/2024

CODE COMPLIANT LANDSCAPE PLAN EXHIBIT

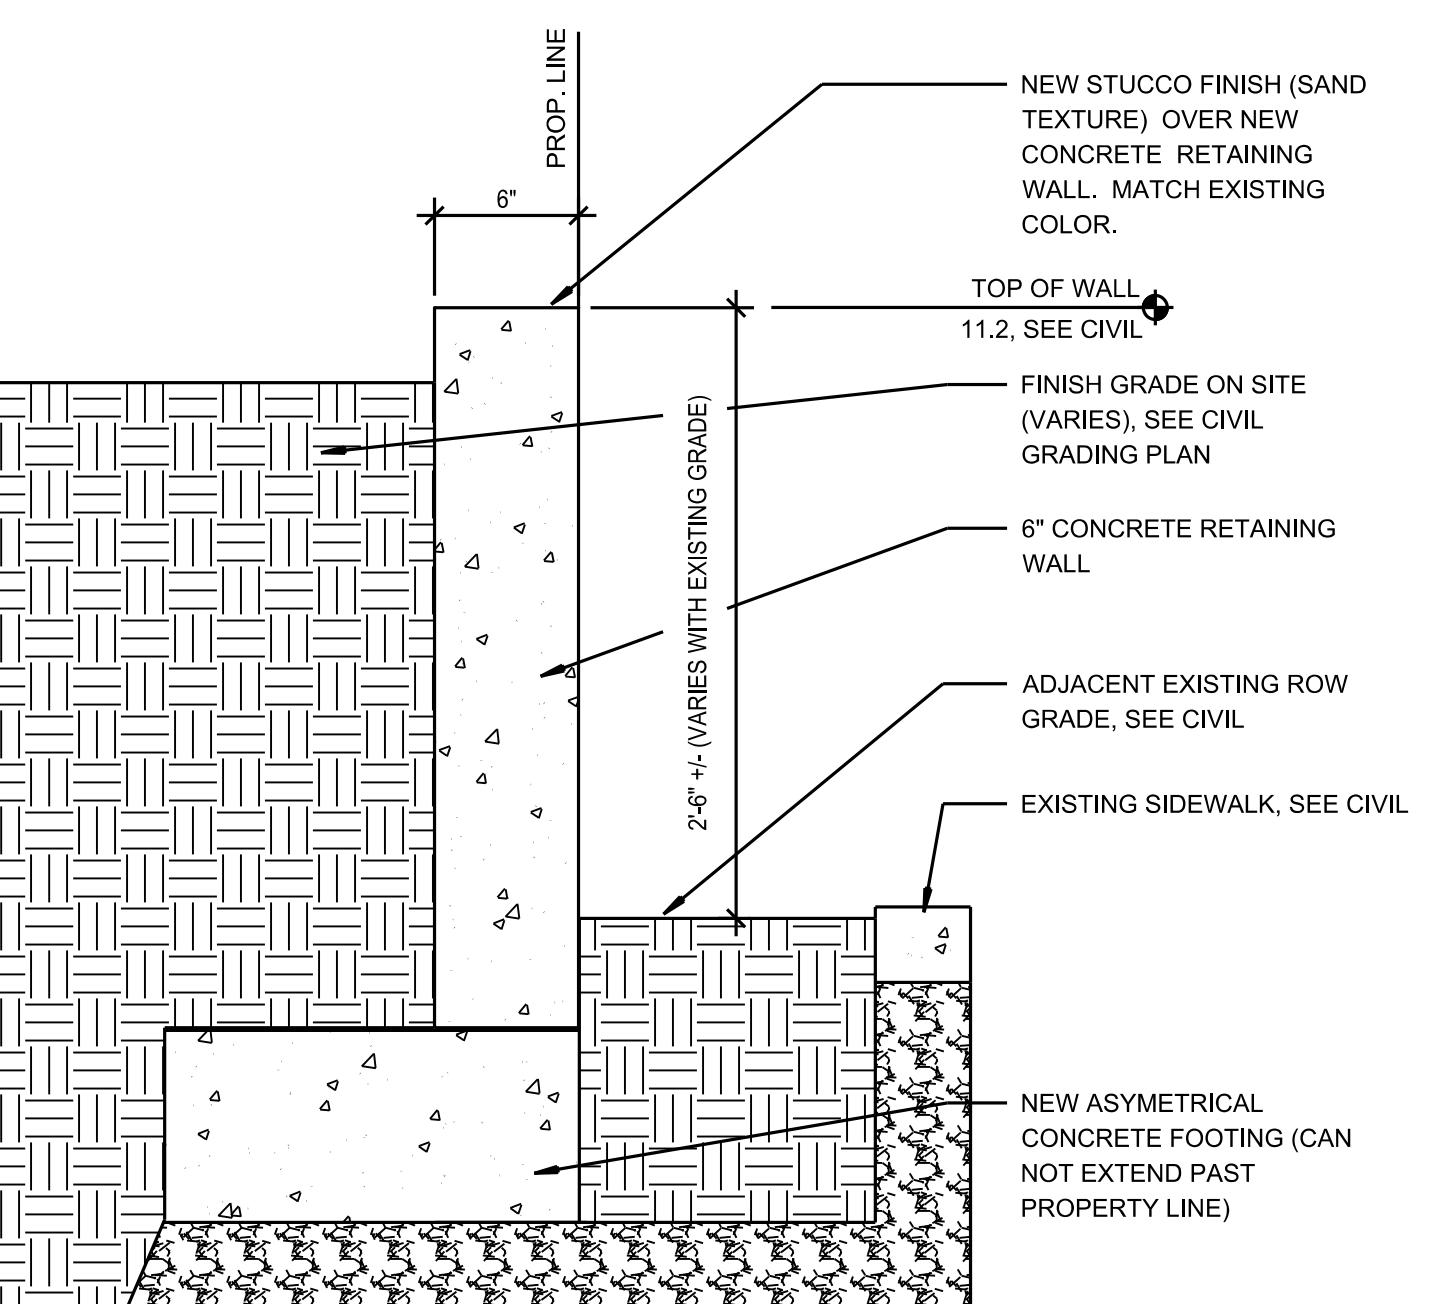

RELATED CASE # C9-83-49

RETAINING WALL DETAIL

(SEE ARCHITECTURAL PLANS)

Contact Arizona 811 at least two full working days before you begin excavation
Call 811 or click Arizona811.com

ARIZONA 811

TD-DEV-0723-00304


SD-0723-00076

TC-DMO-1123-00237


SCA HORIZ : 1" = 20'

CA VERT : N/A


SHET 1 OF 1

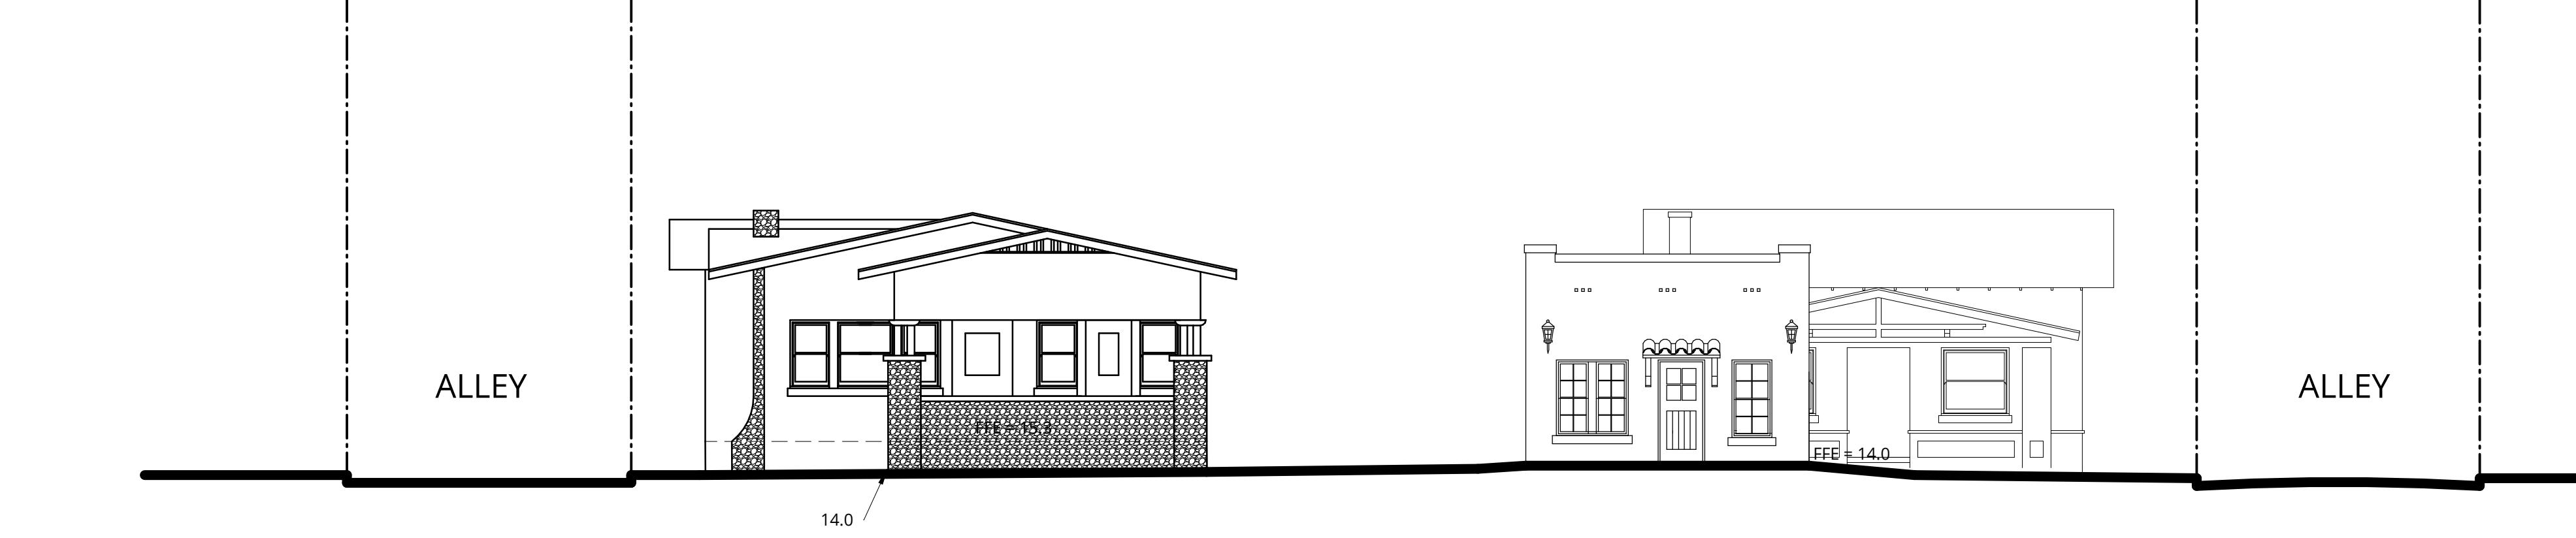


1 EAST ELEVATION FROM JACOBUS AVE
1/8" = 1'-0"

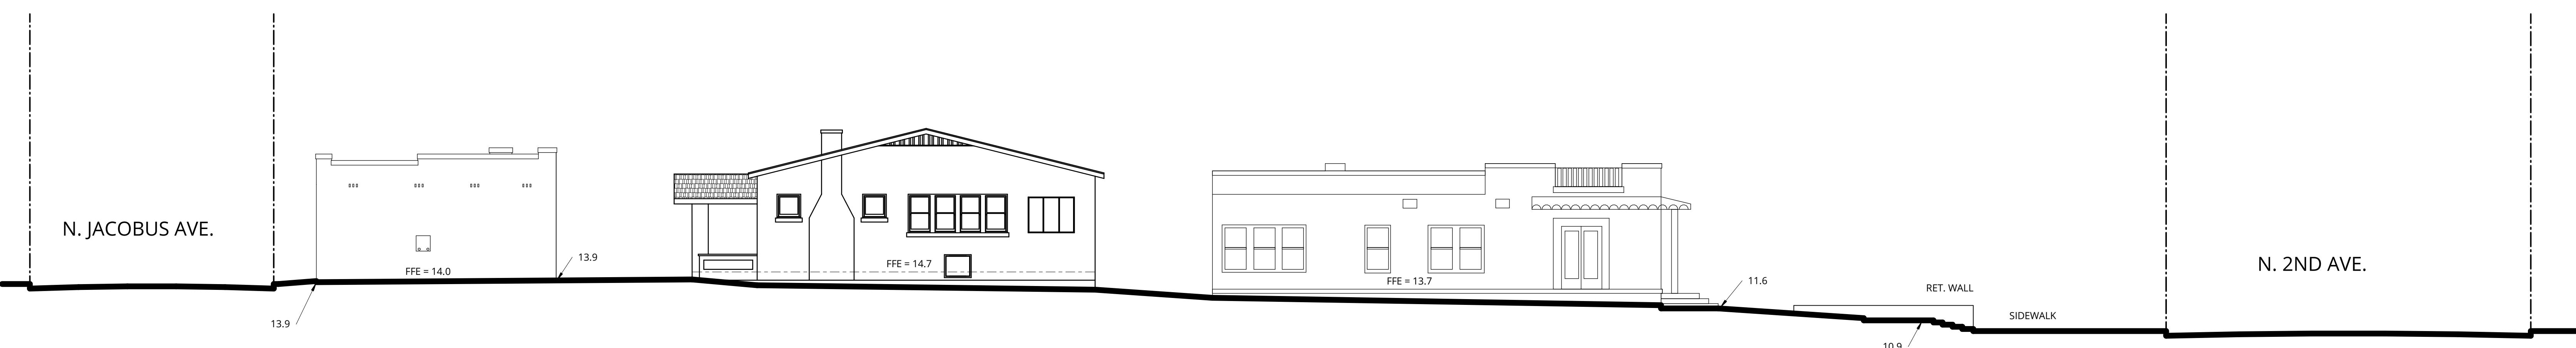


2 NORTH ELEVATION FROM ALLEY
1/8" = 1'-0"

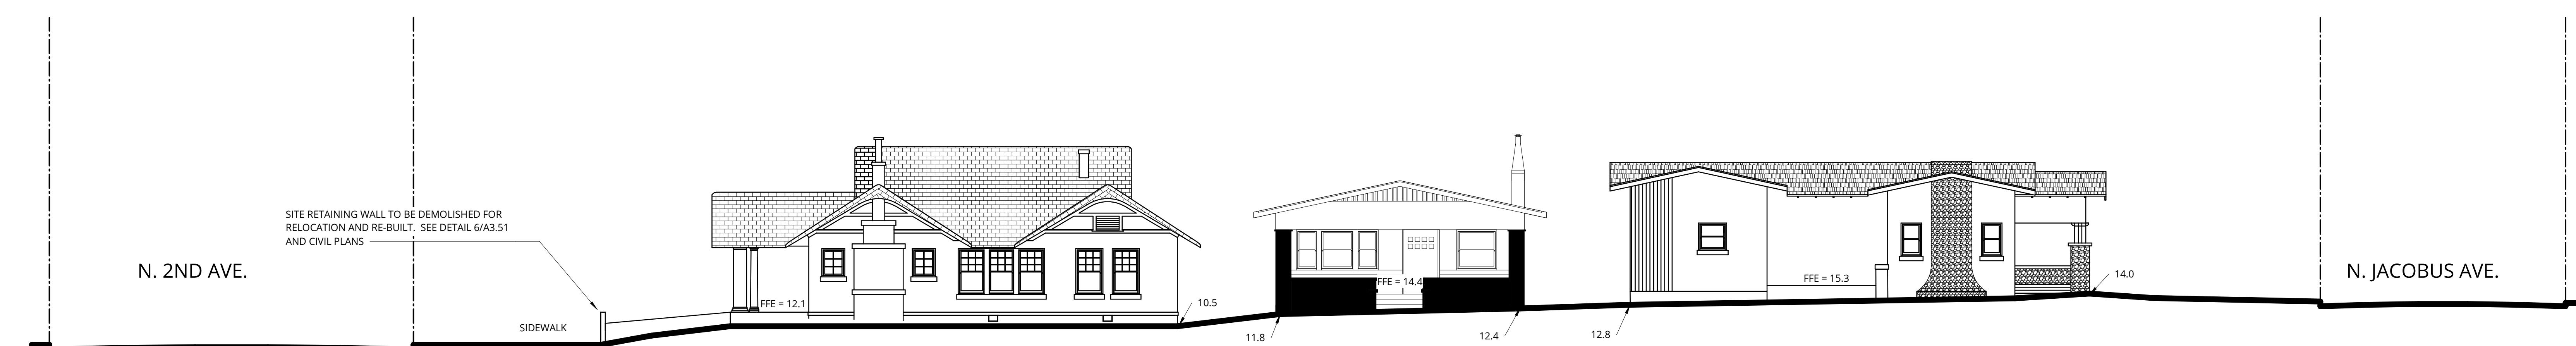


3 SOUTH ELEVATION FROM ALLEY
1/8" = 1'-0"

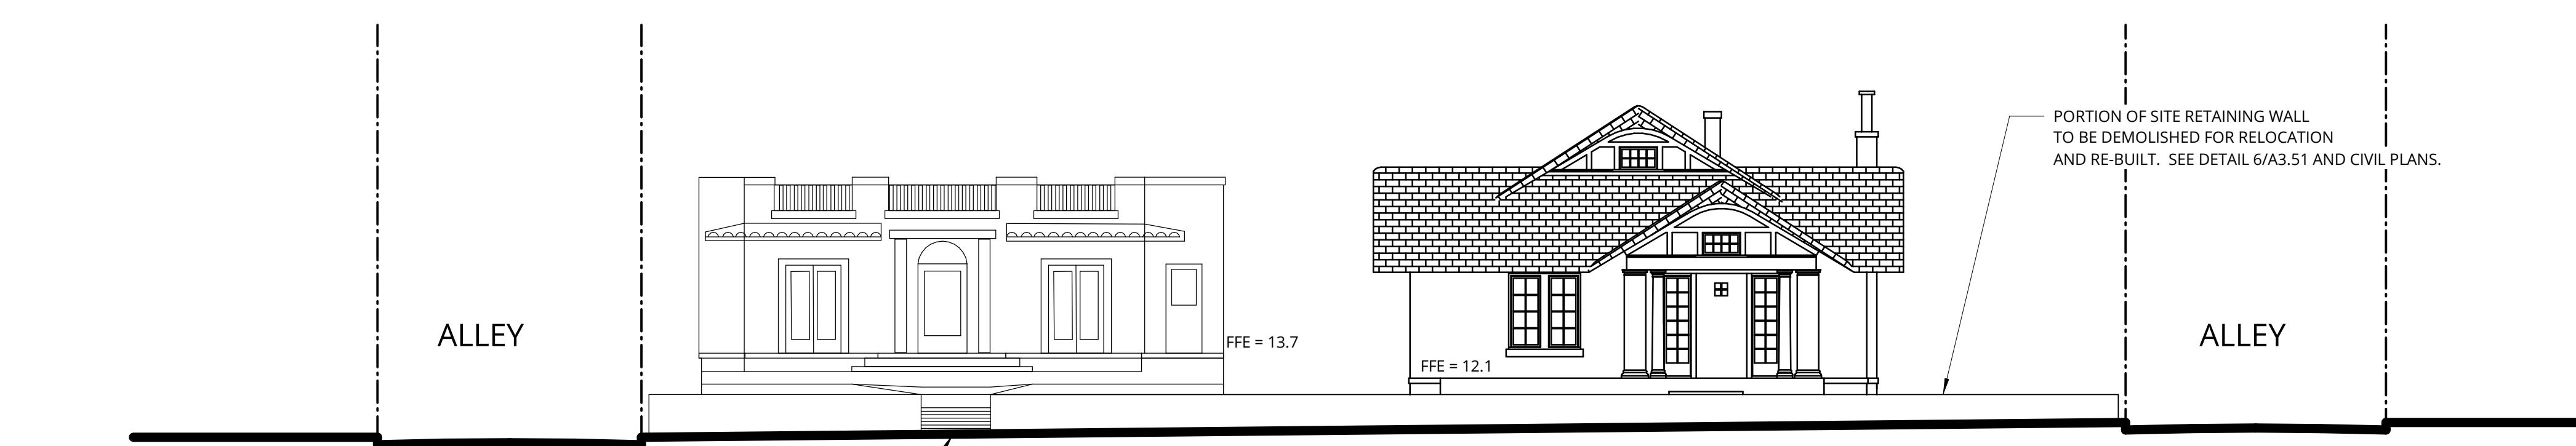

4 WEST ELEVATION FROM N 2ND AVE
1/8" = 1'-0"

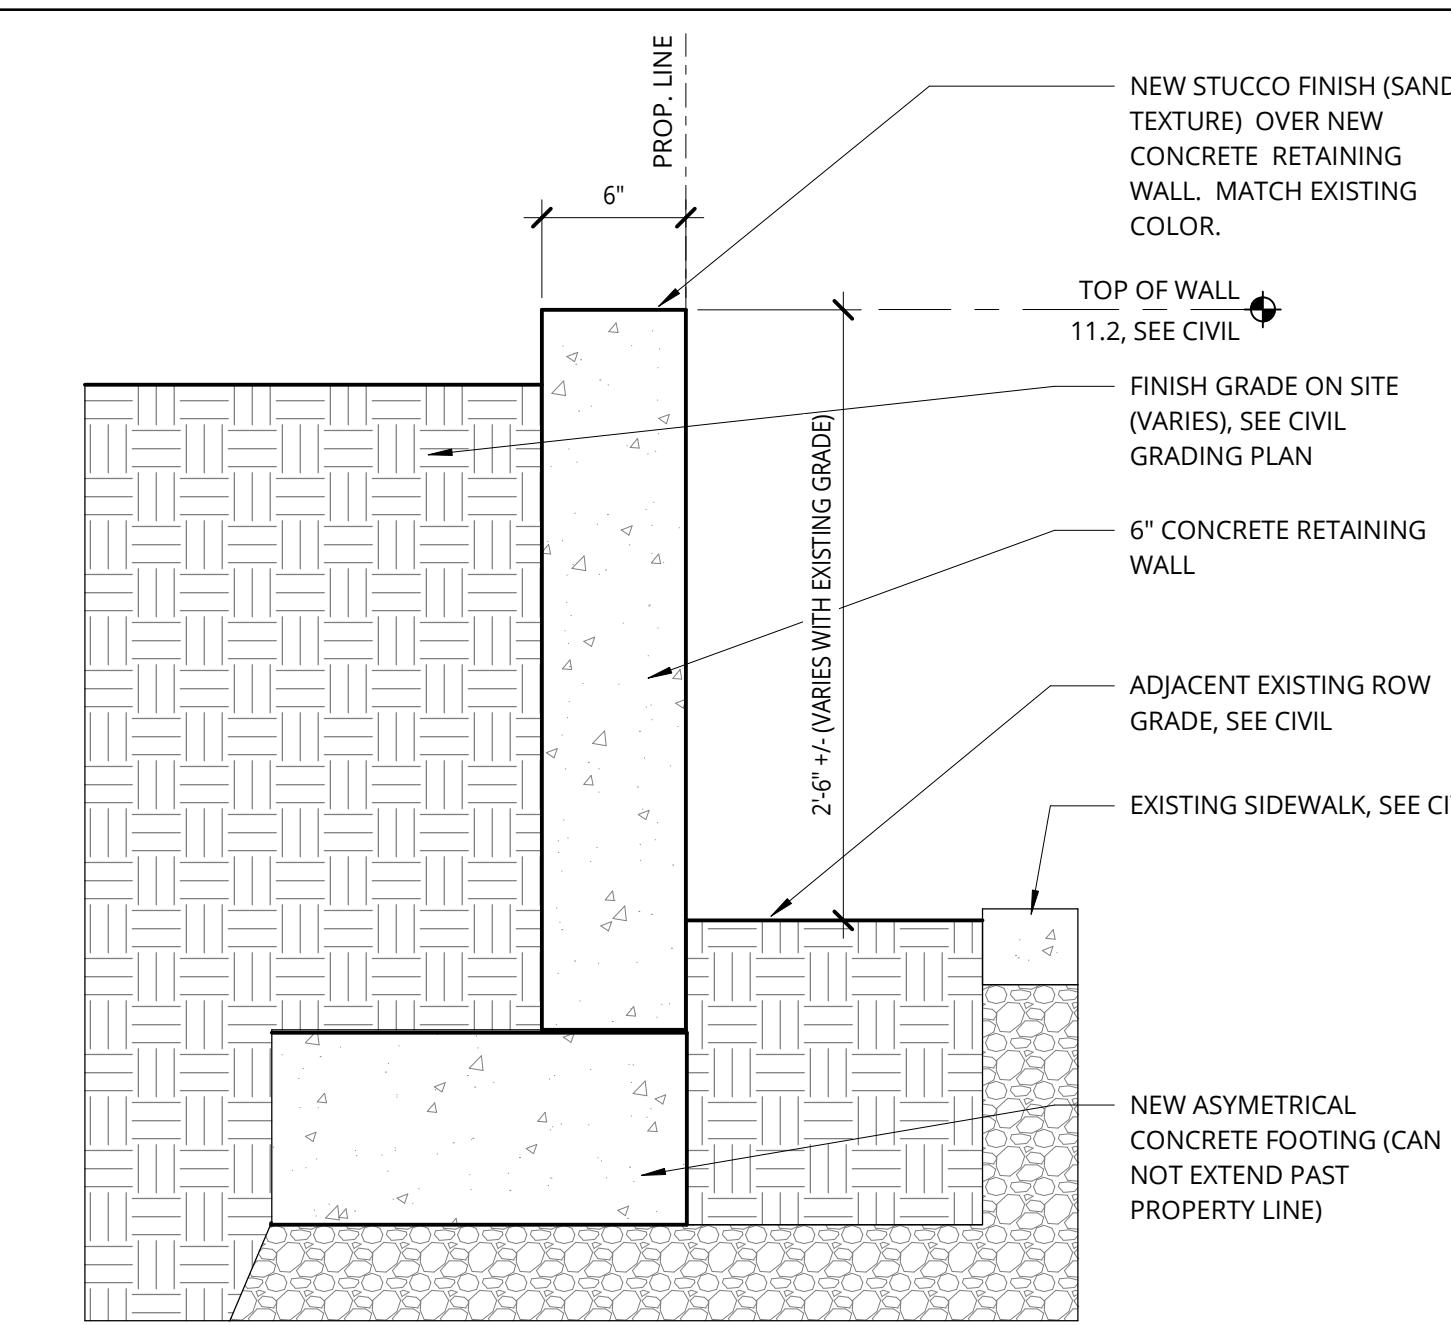

6 RETAINING WALL DETAIL - 2ND AVE.
1 1/2" = 1'-0"

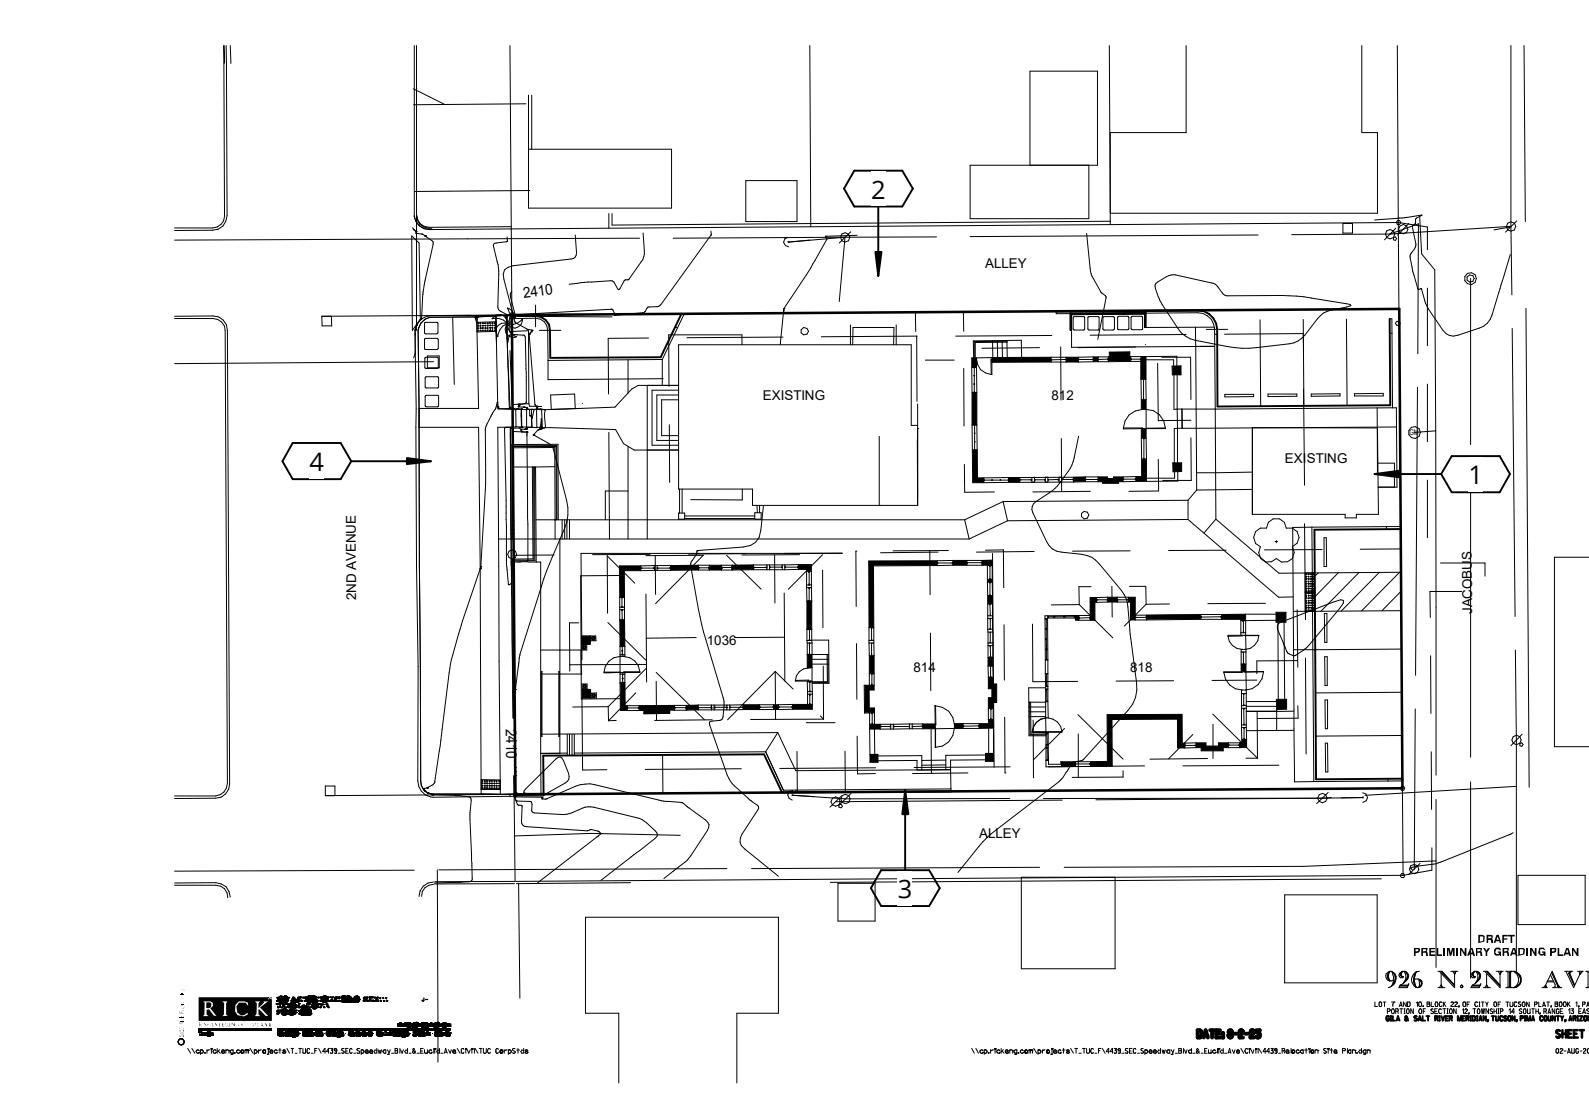

5 KEY PLAN - STREET ELEVATIONS
1" = 40'-0"

NOT FOR
CONSTRUCTION



38 NORTHWEST DAVIS, SUITE 300
PORTLAND, OR 97209
503.245.7100

1505 5TH AVE, SUITE 300
SEATTLE, WA 98101
206.576.1600

1014 HOWARD STREET
SAN FRANCISCO, CA 94103
415.252.7063

© ANKROM MOISAN ARCHITECTS, INC.

TUCSON SPEEDWAY HISTORICAL HOUSES RELOCATION

926 N. 2ND AVE
TUCSON, AZ

Capstone Collegiate Communities/JSC LLC

REVISION	DATE	REASON FOR ISSUE

STREET ELEVATIONS

CONCEPT DESIGN

DATE 04/09/2024 PROJECT NUMBER 184170

SHEET NUMBER

A3.51

NOT FOR
CONSTRUCTION38 NORTHWEST DAVIS, SUITE 300
PORTLAND, OR 97209
503.245.71001505 5TH AVE, SUITE 300
SEATTLE, WA 98101
206.576.16001014 HOWARD STREET
SAN FRANCISCO, CA 94103
415.252.7063

© ANKROM MOISAN ARCHITECTS, INC.

TUCSON SPEEDWAY HISTORICAL HOUSES RELOCATION

Capstone Collegiate Communities/JSC LLC

REVISION	DATE	REASON FOR ISSUE


818 - FLOOR PLANS
AND SCHEDULES

CONCEPT DESIGN

DATE	PROJECT NUMBER
04/09/2024	184170

SHEET NUMBER

A2.04

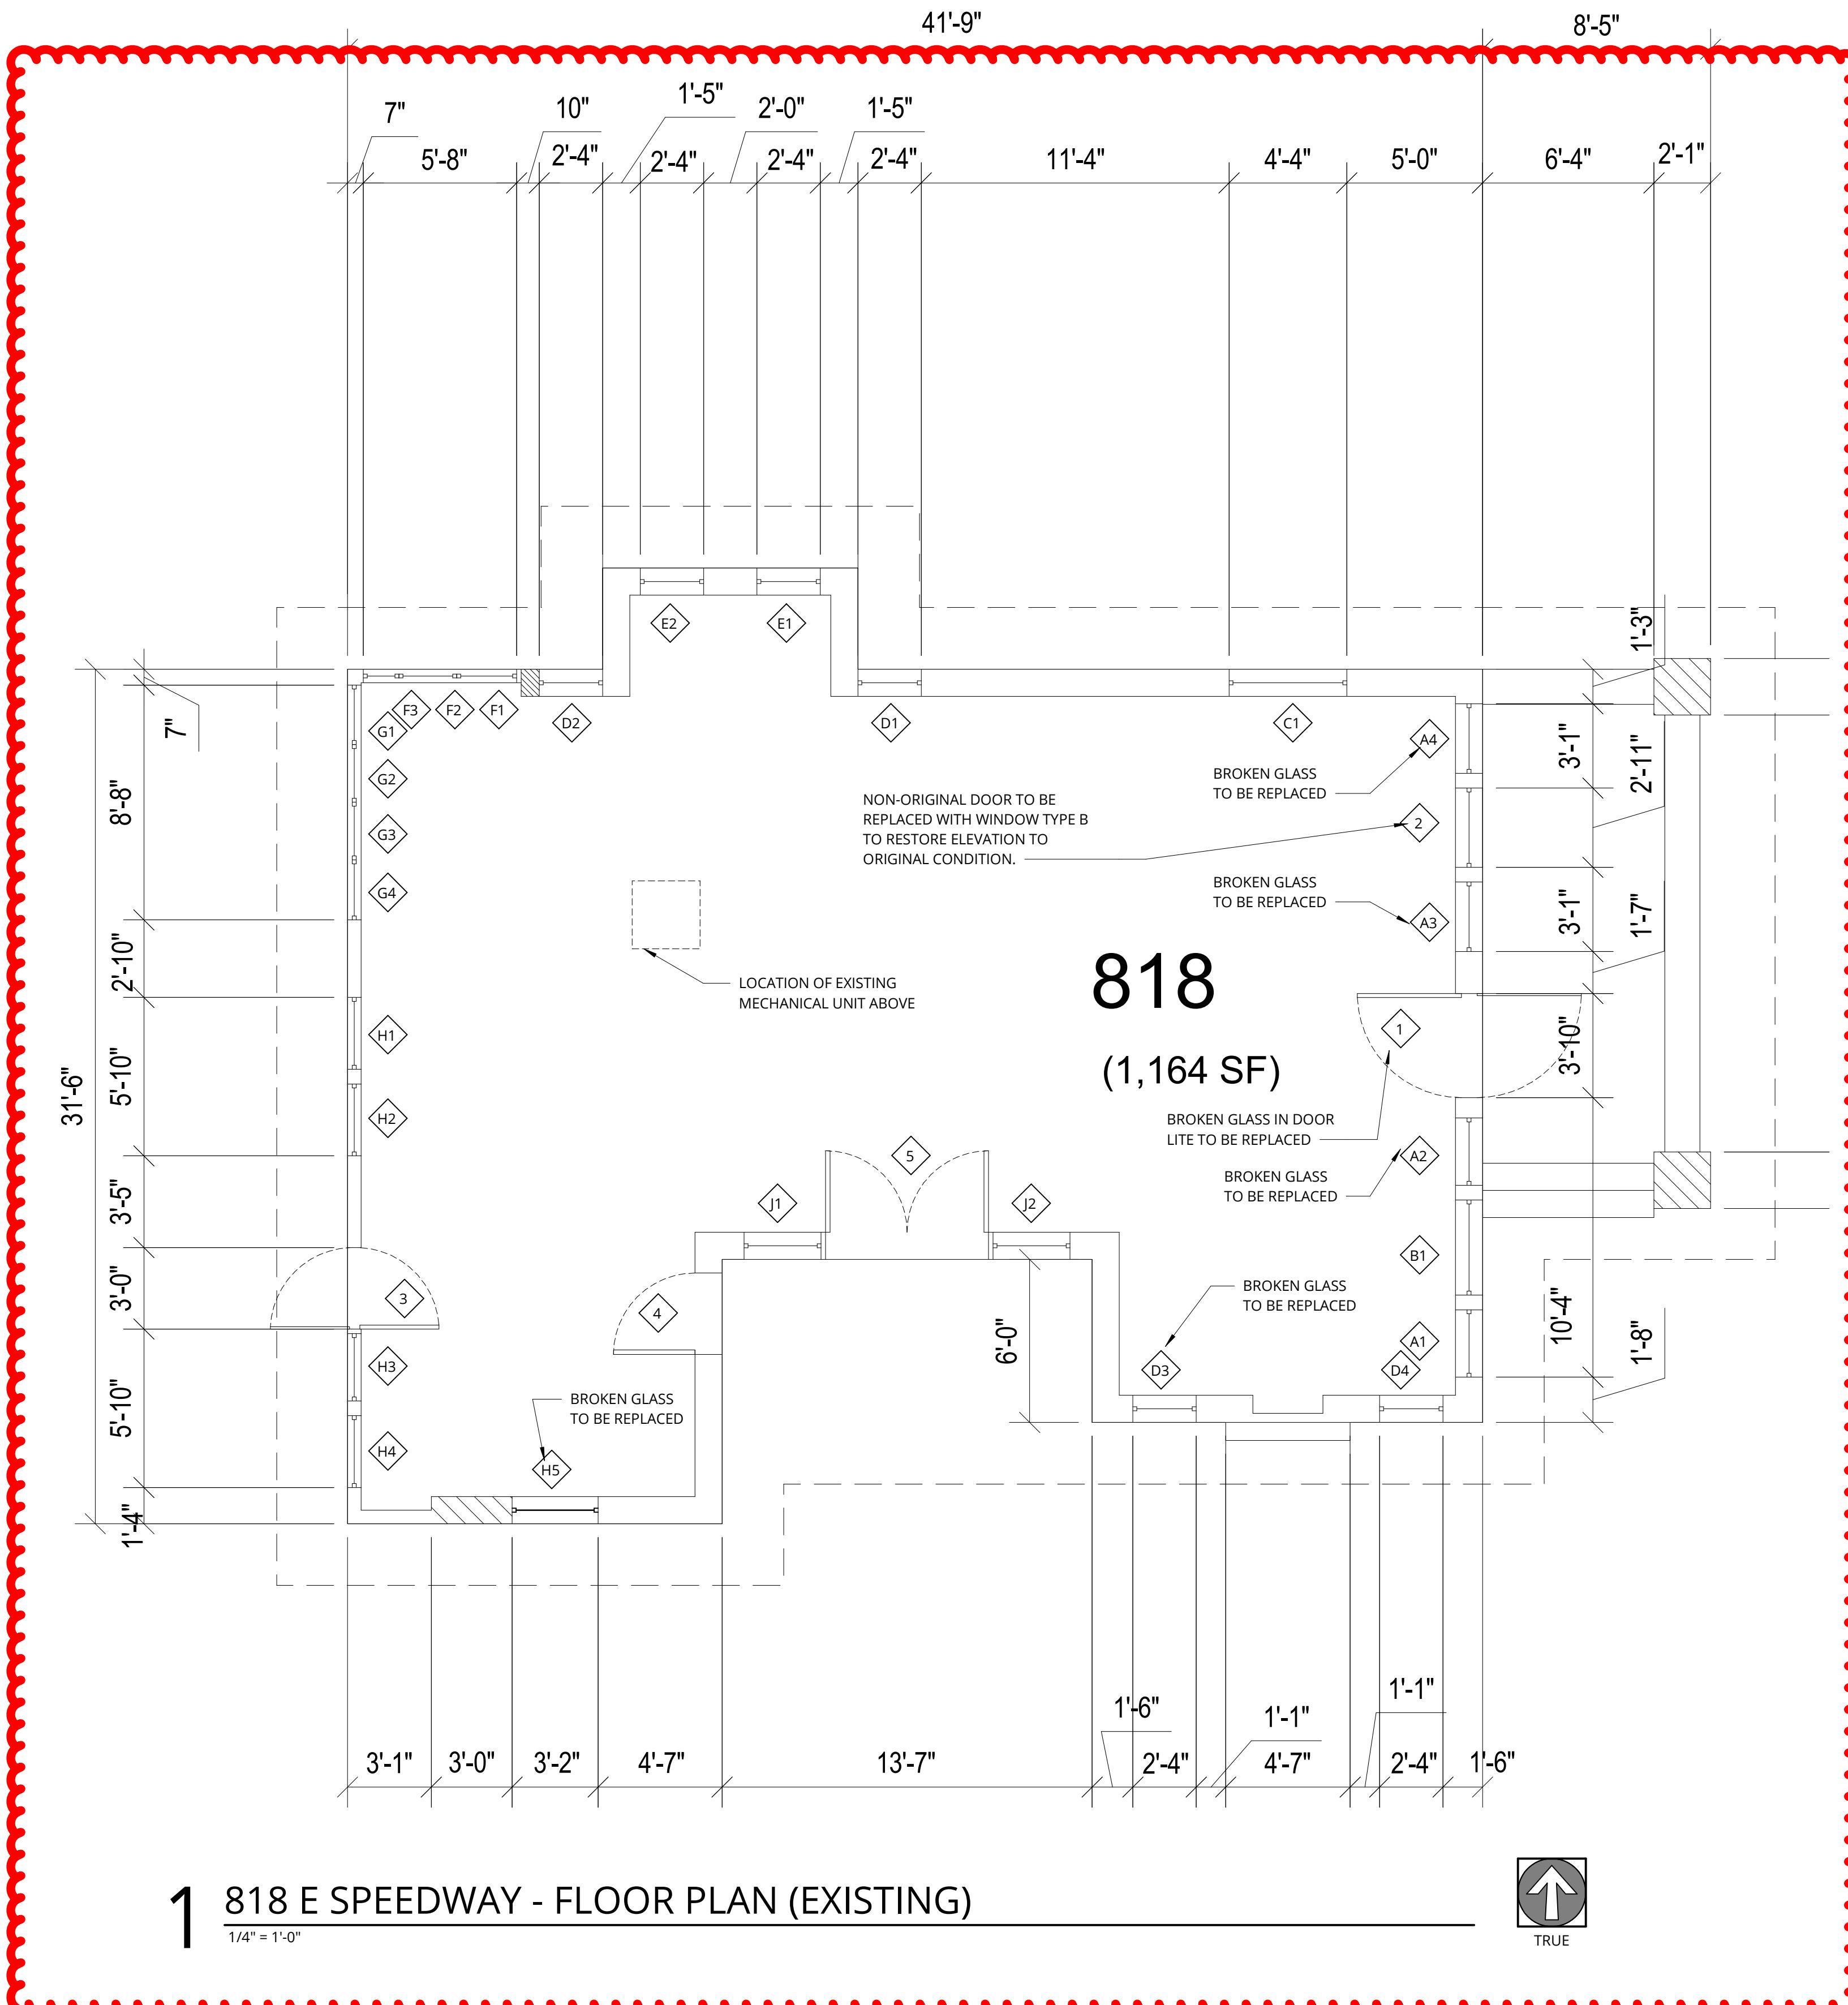


DOOR SCHEDULE							818
NO.	DESCRIPTION	SIZE			COLOR	GLAZING	COMMENTS
		WIDTH	HEIGHT	TYPE			
1	FRONT DOOR	3'-10"	6'-8"	PANEL	WOOD	PAINTED	Y 1, 2, 3
2	FRONT DOOR	2'-11"	6'-8"	PANEL	WOOD	PAINTED	Y 5
3	BACK DOOR	3'-0"	6'-8"	PANEL	WOOD	PAINTED	
4	SIDE PORCH DOOR	3'-0"	6'-8"	FULL GLAZED	WOOD	PAINTED	Y 1, 2, 3
5	SIDE PORCH DOOR (PAIR)	(2) 3'-0"	6'-8"	FULL GLAZED	WOOD	PAINTED	Y 1, 2, 3

COMMENTS LEGEND							
1	SCRAPE, SAND, PRIME AND PAINT DOOR						
2	EXISTING HARDWARE TO BE RE-USED AND RE-KEYED.						
3	EXISTING DOOR TO REMAIN						
4	NEW DOOR						
5	EXISTING DOOR TO BE REMOVED AND WINDOW ADDED TO RESTORE ELEVATION TO ORIGINAL CONDITION						

WINDOW SCHEDULE							
MARK	DESCRIPTION	SIZE			TYPE	MATERIAL	FINISH
		WIDTH	HEIGHT	QTY			
A	SINGLE	2'-4"	4'-0"	4	DOUBLE HUNG	WOOD	PAINTED
B	SINGLE	3'-6"	4'-0"	1	DOUBLE HUNG	WOOD	PAINTED
C	SINGLE	4'-0"	4'-0"	1	DOUBLE HUNG	WOOD	PAINTED
D	SINGLE	2'-0"	3'-0"	4	DOUBLE HUNG	WOOD	PAINTED
E	SINGLE	2'-0"	3'-6"	2	DOUBLE HUNG	WOOD	PAINTED
F	SINGLE	2'-0"	4'-2"	3	DOUBLE HUNG	WOOD	PAINTED
G	SINGLE	2'-0"	4'-2"	4	DOUBLE HUNG	WOOD	PAINTED
H	SINGLE	2'-6"	3'-2"	5	DOUBLE HUNG	WOOD	PAINTED
J	SINGLE	3'-0"	6'-8"	2	FIXED	WOOD	PAINTED

COMMENT LEGEND							
1	SCRAPE, SAND, PRIME AND PAINT EXISTING WINDOWS TO REMAIN.						
2	ALL WINDOWS TO BE BOARDED WITH 1/2" OSB FOR MOVE.						
3	EXISTING AC UNIT TO BE DEMOLISHED AND WINDOW RESTORED TO ORIGINAL CONDITION						
4	SEE PLANS AND ELEVATIONS FOR SPECIFIC WINDOW IDENTIFIERS. ANY NEW OR REPLACEMENT WINDOWS TO BE KOLBE HERITAGE SERIES OR APPROVED EQUAL. MATCH EXISTING SIZE, OPERATION, DETAIL, AND COLORING						
5	REPLACEMENT WINDOWS TO BE PROCURED PER THIS NOTE.						

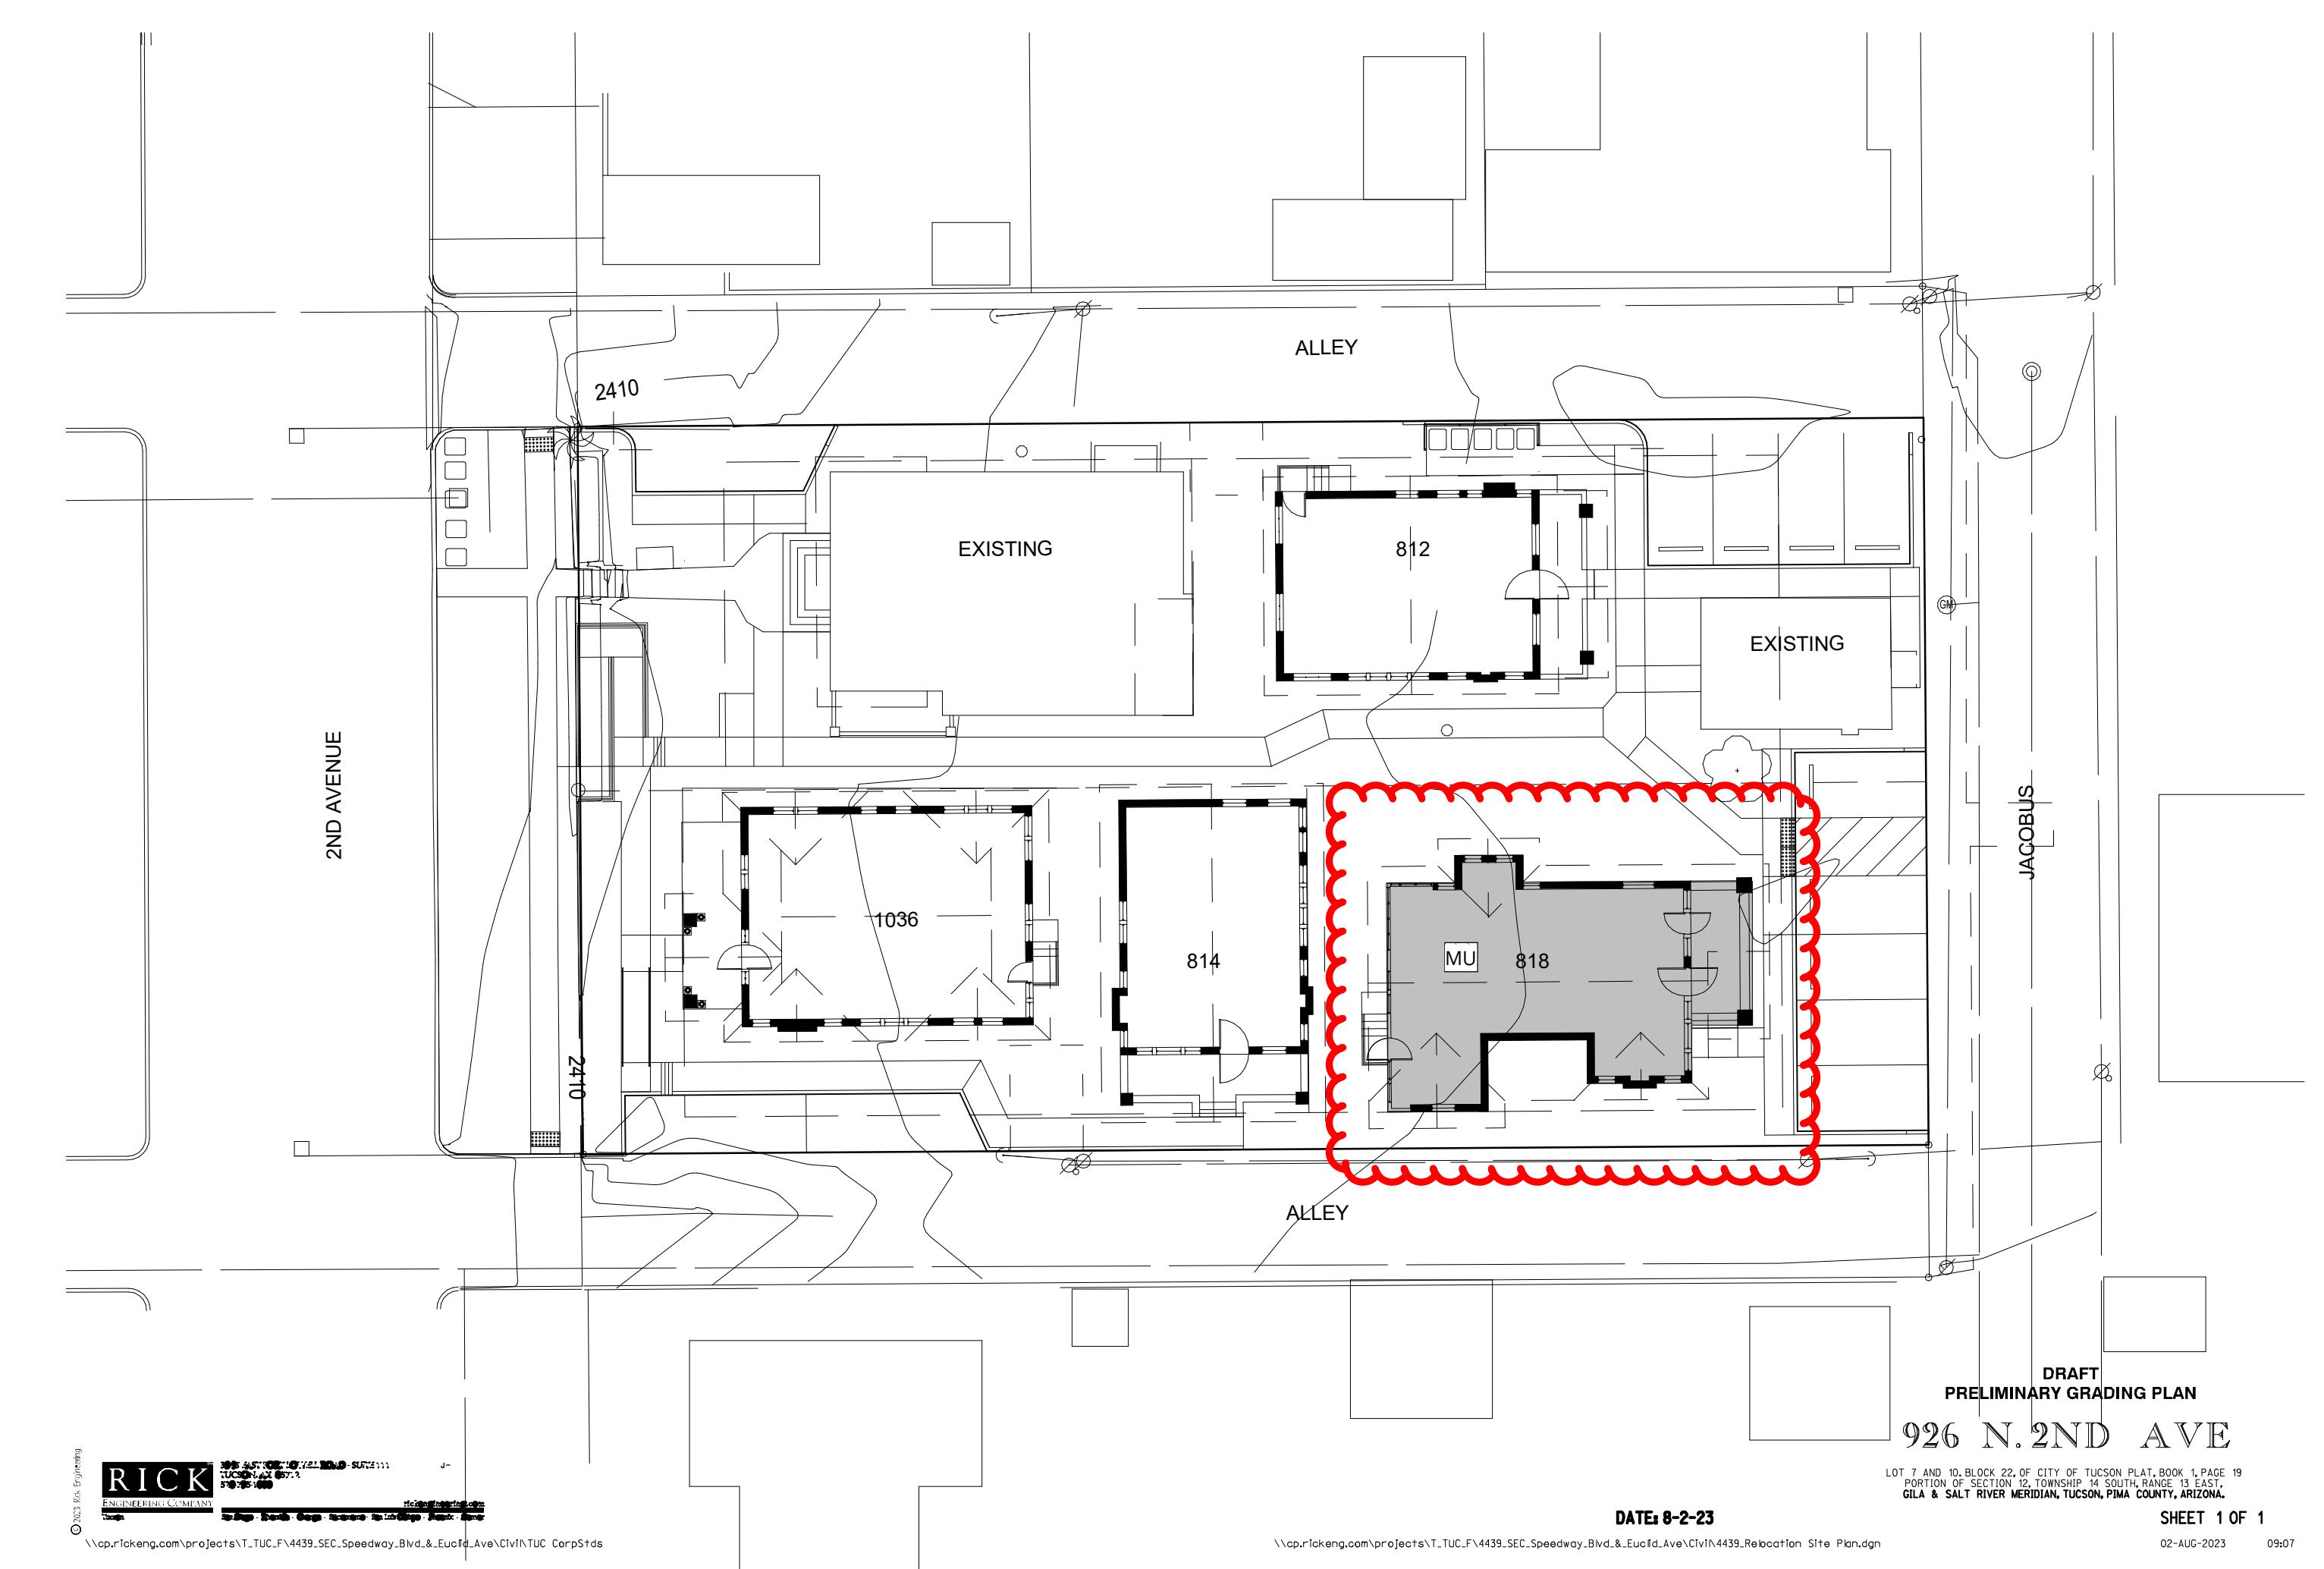

3 KEY PLAN - NEW LOCATION - 818 E SPEEDWAY
NTS | A2.04



EAST ELEVATION (FORMERLY NORTH ELEVATION)

EAVES, RAKES AND RAFTER TAILS TO BE SCRAPED, Sanded, PRIMED, AND PAINTED.

CLUSTERED PORCH POSTS TO BE SALVAGED AND RE-INSTALLED.

COBBLESTONE COLUMN TO BE DECONSTRUCTED, SALVAGED AND RE-INSTALLED AT NEW LOCATION.

PARTIAL HEIGHT COBBLESTONE PORCH WALL TO BE DECONSTRUCTED, SALVAGED AND RECONSTRUCTED AT NEW LOCATION.



EAST ELEVATION (FORMERLY NORTH ELEVATION)



EAST ELEVATION (FORMERLY NORTH ELEVATION)


BROKEN GLASS TO BE REPLACED. SEE PLANS AND WINDOW SCHEDULE FOR LOCATIONS.

ORIGINAL ENTRY DOOR TO BE SCRAPED, Sanded, PRIMED, AND PAINTED. BROKEN GLASS TO BE REPLACED IN DOOR LITE.

DOOR TRIM TO BE REMOVED AS NEEDED AND RESTORED TO NEW CONDITION.

STUCCO FINISH TO BE PATCHED, TEXTURED AND PAINTED TO MATCH ADJACENT WALL.

NEW CONCRETE FLOOR SLAB TO MATCH EXISTING FOR COLOR, TEXTURE AND SCORING PATTERN.

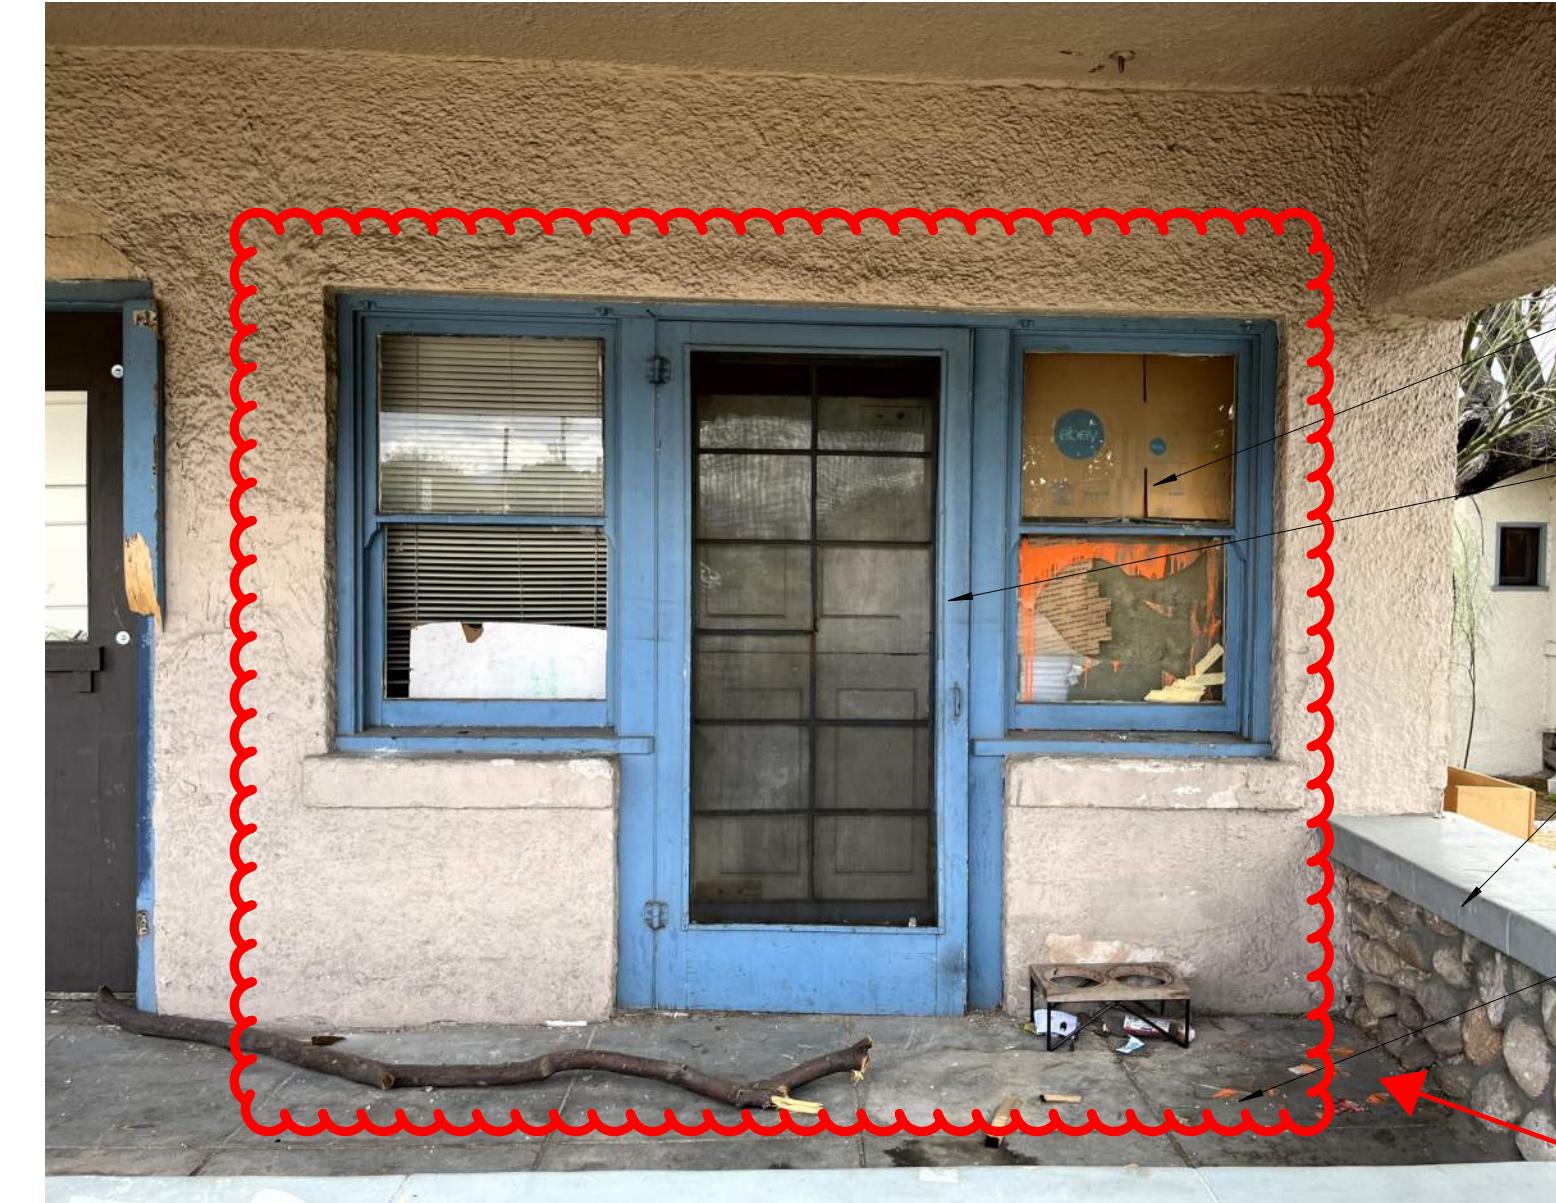

EAST ELEVATION (FORMERLY NORTH ELEVATION)

BROKEN GLASS TO BE REPLACED. SEE PLANS AND WINDOW SCHEDULE FOR LOCATIONS.

NON-ORIGINAL DOOR TO BE DEMOLISHED AND REPLACED WITH WINDOW TO RESTORE ORIGINAL CONDITION. SEE ELEVATIONS.

PARTIAL HEIGHT COBBLESTONE PORCH WALL TO BE DECONSTRUCTED, SALVAGED AND RECONSTRUCTED AT NEW LOCATION.

NEW CONCRETE FLOOR SLAB TO MATCH EXISTING FOR COLOR, TEXTURE AND SCORING PATTERN.



SOUTH ELEVATION (FORMERLY EAST ELEVATION)

PRIMARY COBBLESTONE CHIMNEY TO BE DECONSTRUCTED, SALVAGED AND RE-BUILT AT NEW LOCATION.

EAVES, RAKES AND RAFTER TAILS TO BE SCRAPED, Sanded, PRIMED, AND PAINTED.

PRIMARY COBBLESTONE CHIMNEY TO BE DECONSTRUCTED, SALVAGED AND RE-BUILT AT NEW LOCATION.




SOUTH ELEVATION (FORMERLY EAST ELEVATION)

WINDOWS FRAMES TO BE SCRAPED, Sanded, PRIMED, AND PAINTED. SEE WINDOW SCHEDULE FOR MORE INFORMATION.

EXISTING UTILITIES TO BE DEMOLISHED. PATCH STUCCO FINISH AS REQUIRED TO MATCH EXISTING ADJACENT WALL.

PRIMARY COBBLESTONE CHIMNEY TO BE DECONSTRUCTED, SALVAGED AND RE-BUILT AT NEW LOCATION.

STUCCO FINISH TO BE PATCHED, TEXTURED AND PAINTED TO MATCH ADJACENT WALL.

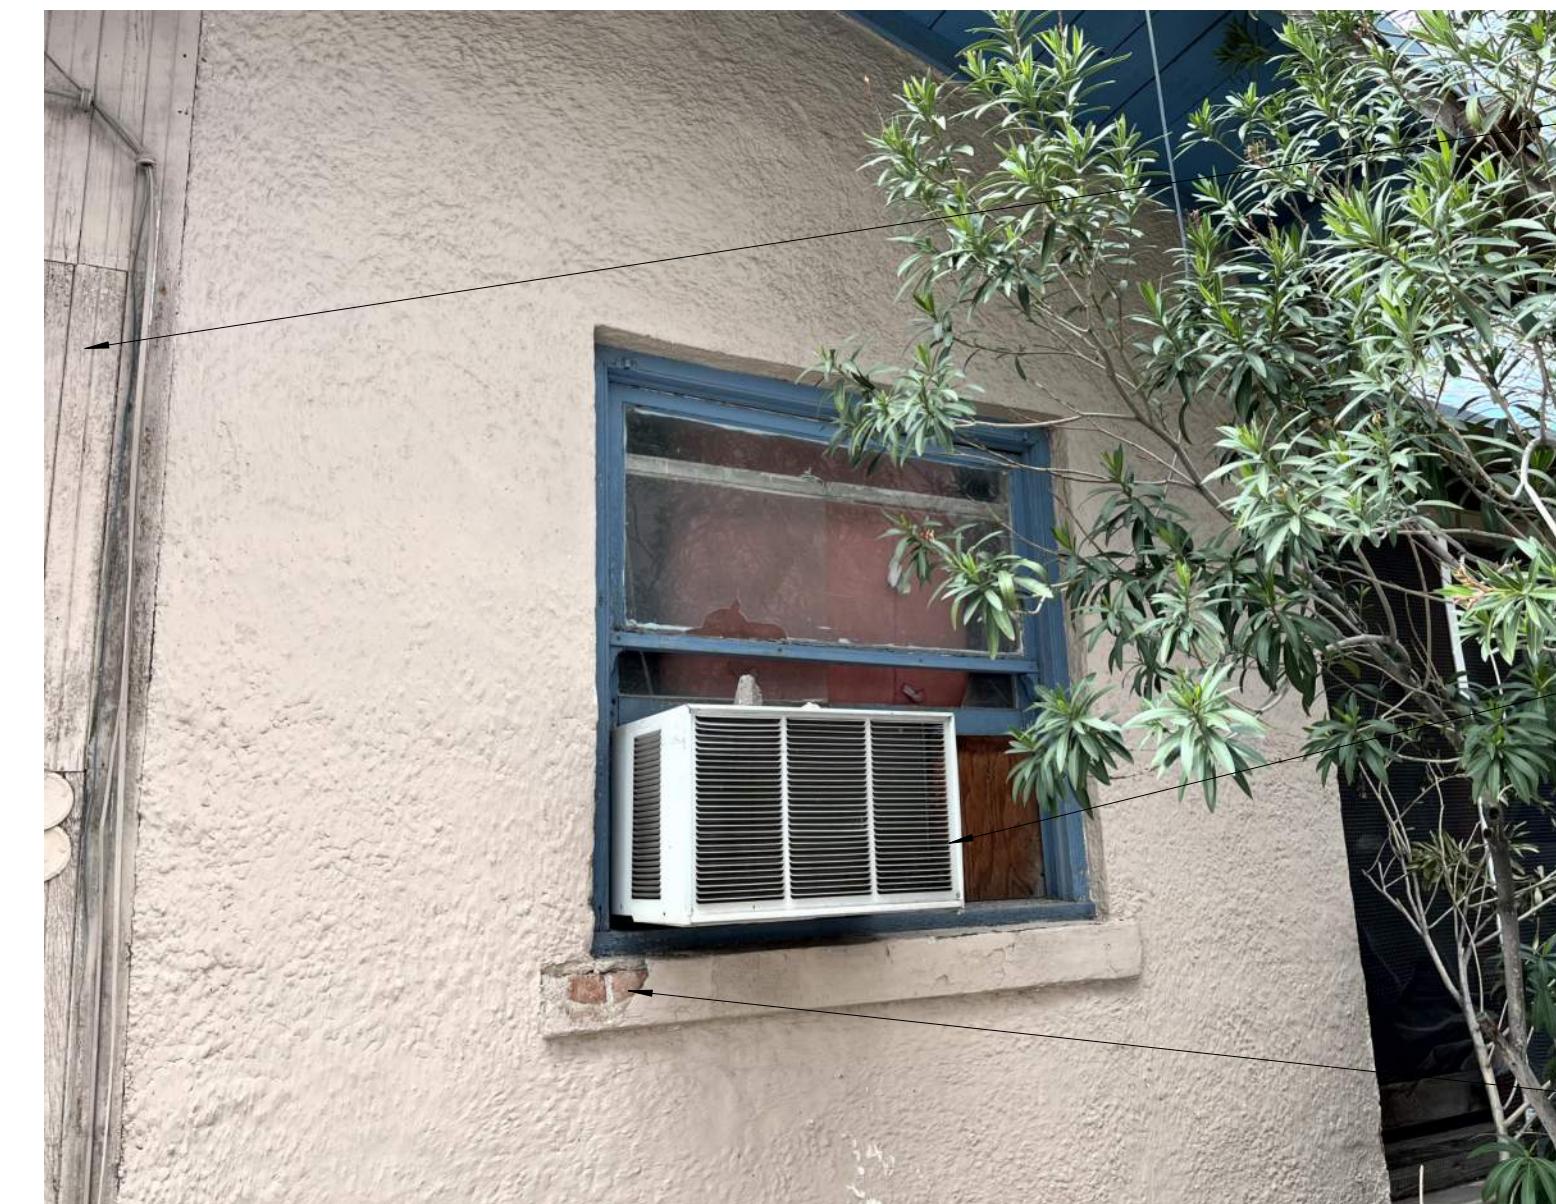


SOUTH ELEVATION (FORMERLY EAST ELEVATION)

EXISTING WOOD SIDING TO BE SCRAPED, Sanded, PRIMED, AND PAINTED.


WINDOW MOUNTED AC UNIT TO BE REMOVED.

STUCCO FINISH TO BE PATCHED, TEXTURED AND PAINTED TO MATCH ADJACENT WALL.

PER OUR ONSITE MEETING, THIS DOOR TO REMAIN IN PLACE. REPAIR AND REPAINT.

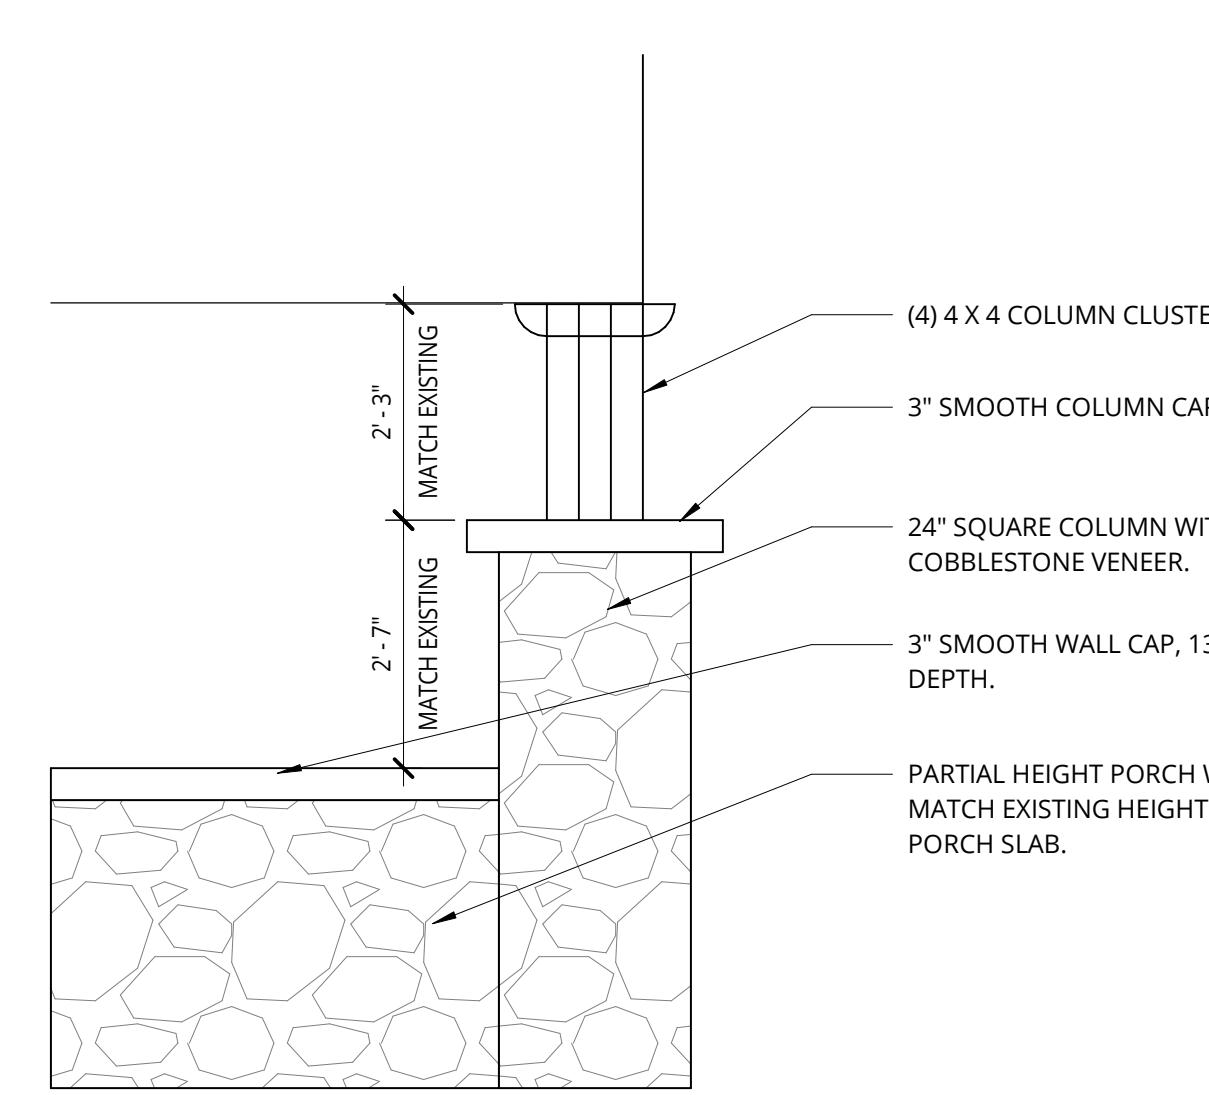

1 COLUMN DETAIL - 818

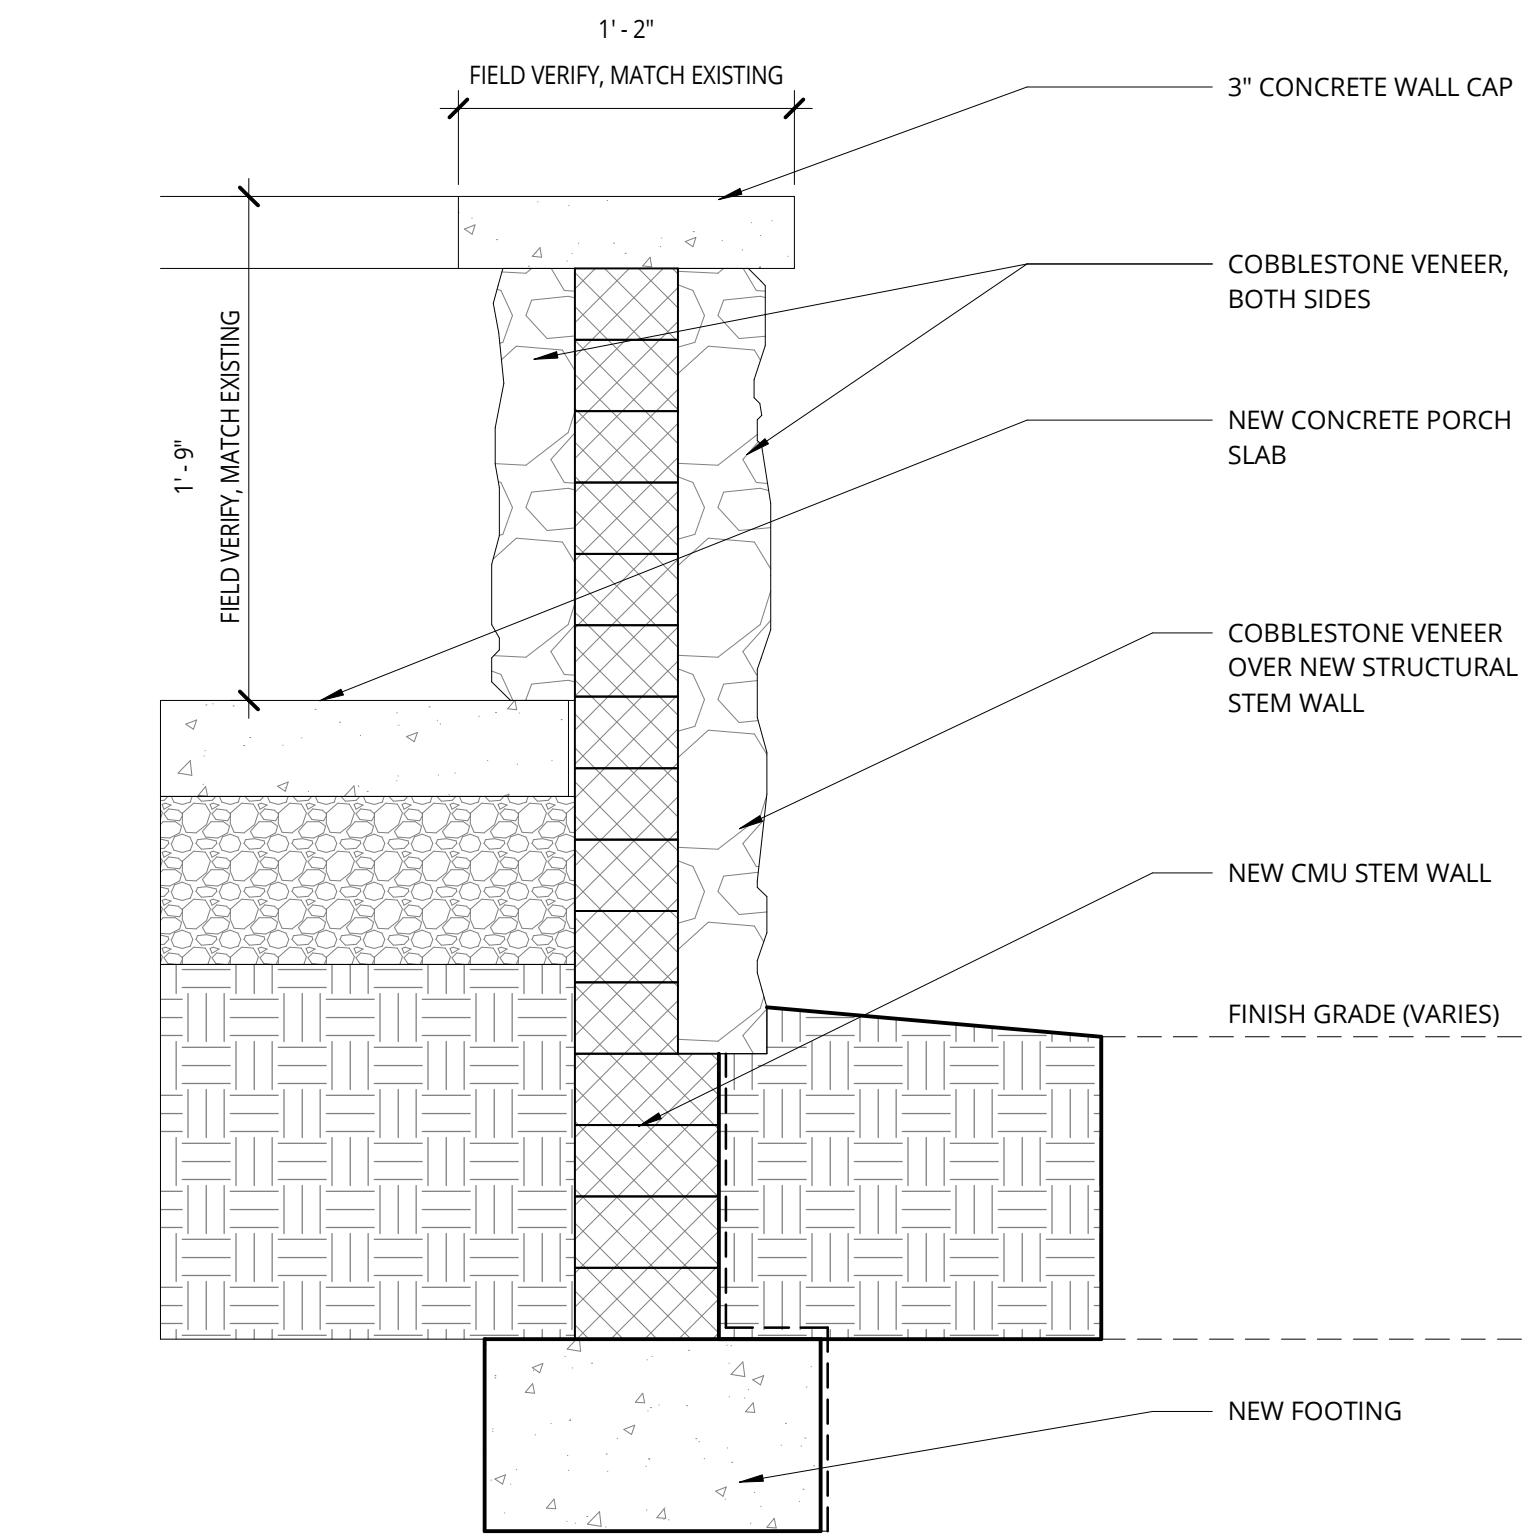

2 PORCH WALL DETAIL - 818

TUCSON SPEEDWAY HISTORICAL HOUSES RELOCATION

Capstone Collegiate Communities/JSC LLC

Tucson, AZ

REVISION	DATE	REASON FOR ISSUE

818 - DETAILS

CONCEPT DESIGN

DATE	PROJECT NUMBER
04/09/2024	184170

SHEET NUMBER

184170

A7.24

NOT FOR CONSTRUCTION

38 NORTHWEST DAVIS, SUITE 300
PORTLAND, OR 97209
503.245.71001505 5TH AVE, SUITE 300
SEATTLE, WA 98101
206.576.16001014 HOWARD STREET
SAN FRANCISCO, CA 94103
415.252.7063

© ANKROM MOISAN ARCHITECTS, INC.



PICTURE DOCUMENTATION
FROM OUR ONSITE MEETING
TO SHOW CURRENT STAGE
OF WOOD SIDING.



PICTURE DOCUMENTATION FROM OUR
ONSITE MEETING TO SHOW CURRENT STAGE
OF WOOD SIDING.



PICTURE DOCUMENTATION FROM OUR
ONSITE MEETING TO SHOW CURRENT STAGE
OF WOOD SIDING.





PICTURE DOCUMENTATION FROM OUR
ONSITE MEETING TO SHOW CURRENT STAGE
OF WOOD SIDING.

PICTURE DOCUMENTATION FROM OUR
ONSITE MEETING TO SHOW CURRENT STAGE
OF WOOD SIDING.



OLD PICTURE FOR REFERENCE.

PROPOSED WINDOW REPLACEMENT FOR NORTH AND WEST ELEVATION.
THIS IN LINE WITH COMMENT LEGEND #5 ON THE APPROVED PLANS SHEET
A2.04, REFERENCE BELOW-

5 ANY NEW OR REPLACEMENT WINDOWS TO BE KOLBE HERITAGE SERIES OR APPROVED EQUAL.

MATCH EXISTING SIZE, OPERATION, DETAIL, AND COLORING



Heritage Series





Photo provided by North Atlantic Corp.


Be Inspired ▶

Click to view more: kolbewindows.com/gallery

Double Hungs

Kolbe offers a variety of double hung windows for residential or commercial projects, from historic restoration to remodeling. Quality details adorn the classic design of Heritage Series all-wood double hungs, with smooth operation, venting options, and removable sash for easy cleaning. There are many options and configurations to choose from, including cottage-style and radius-topped units or triple pane glass options for increased energy efficiency.

*Sterling Double Hungs | XL Sterling Double Hungs | Traditional Double Hungs
Old World Classic Double Hungs | Cottage-Style & Reverse-Cottage Style | Studio & Transom Units
Picture Combination Units | Segment Head & Half-Circle Top Units | Single Hungs*

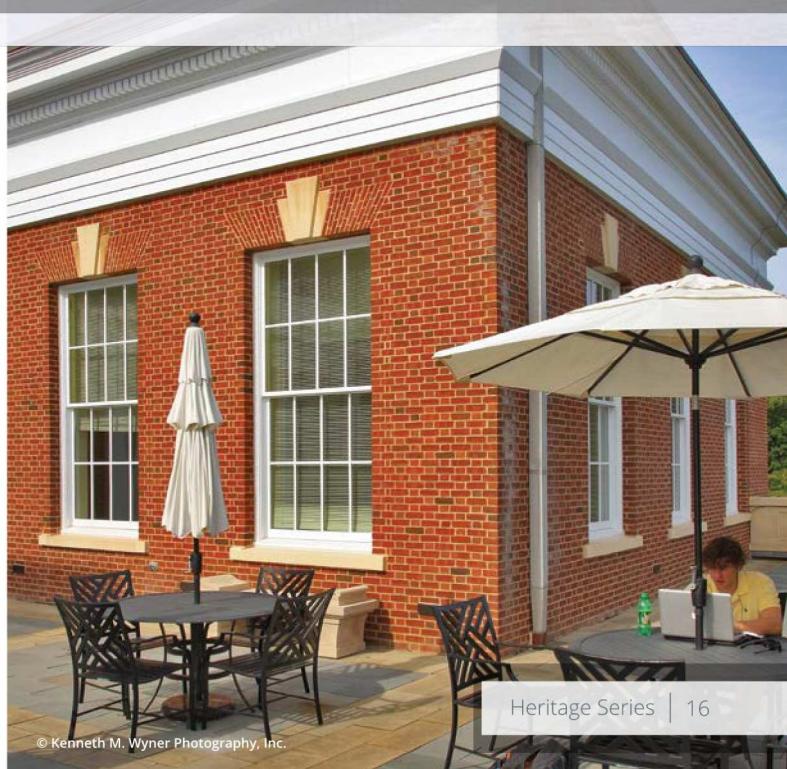

© Kenneth M. Wyner Photography, Inc.

Traditional Double Hungs

Kolbe's traditional double hungs offer classic styling, with a sloped sill to help guard against water damage. Available as cottage-style units or radius-top shapes, traditional double hungs open and close smoothly and effortlessly, with a tilt-in or removable sash for easy cleaning.



© Pearson Photography



Moore Architects, LEED Silver | Photo © Hoachlander Davis Photography

Standard Features – Traditional Double Hung

- ▶ 1-3/8" thick sash
- ▶ Overall jamb depth is 4-9/16" (*basic box depth is 4-9/16"*)
- ▶ Frame thickness is 3/4" at side jambs and head
- ▶ Sill thickness is 1-3/16"; slope is 14°
- ▶ Constructed of pine, with pine interior stops and wood mull casings on mulled units
- ▶ 1-15/16" exterior brickmould applied
- ▶ Exterior wood parts are treated
- ▶ Exterior frame and sash are latex primed
- ▶ Energy efficient, insulating Solar Low-E glass

- ▶ Glazed to the interior with beveled wood glazing beads
- ▶ Rigid PVC head parting stop with flexible fins and waterseal at the sill
- ▶ Clay-colored heavy duty sash lock
- ▶ Machined finger grooves on the top rail of the upper sash and bottom rail of the lower sash
- ▶ Spring-loaded block-and-tackle mechanical balances to carry the sash weight
- ▶ Beige PVC jambliners with compression foam backing

Options – Traditional Double Hung (custom options are also available)

- ▶ K-Kron II exterior paint finish
- ▶ Interior casing
- ▶ Prep for stool
- ▶ Exterior brickmould and casing (*pg. 8*)
- ▶ Projected sill nosing, extended sill horns or no sill nosing
- ▶ No finger grooves in top, bottom or both sash
- ▶ White jambliners
- ▶ Extension jambs (*up to 12" applied, over 12" shipped loose for field application*)

- ▶ Full or half screens with aluminum frames and options for BetterVue® or UltraVue® fiberglass screen mesh or aluminum screen mesh; frames will match the exterior color of the unit
- ▶ Factory-installed Window Opening Control Device (WOCD)
- ▶ Sash limiters for safety
- ▶ Galvanized steel installation clips

[View Style Options & Technical Data ▶](#)

(Click to view hardware, glass, divided lites, finishes, and more, as well as performance and specification details.)

Finish Options

Exterior Colors

Most Heritage Series windows and doors are coated on the exterior with latex primer, ready for your choice of topcoat. Kolbe also offers K-Kron II – a durable exterior finish that enhances and preserves the look of wood windows and doors.

White	Cloud	Ultra Pure White				
Abalone	Alabaster	Camel				
Mudpie	Nutmeg	Khaki	Sahara	Beige	Natural Cotton	Spiced Vinegar
Gingersnap	Truffle	Rustic	Shadow	Shale	Smokestack	Timberwolf
Sapphire	Coastal Storm	Lunar	Steel Gray	Slate	Castlerock	Emerald Isle
Cider	Copper Canyon	Basil	Mystic Ivy	Mediterranean	Green Tea Leaf	Hartford Green
Chutney	Roma	Maize	Custom Colors Available			

Wire Brush Finish

Most of Kolbe's Heritage Series wood windows and doors can be further enhanced by our custom wire brush finish. Wire brushing creates a rugged texture and adds character to complement any rustic design.

Due to the nature of the finishes, certain limitations apply. Contact your local Kolbe dealer for more information.



Some options for our products may have limited color offerings or may incur a nominal charge. Check with your Kolbe dealer for further details on pricing and availability.

Printed images of exterior finishes may vary slightly from actual colors.

Selections should be made based on color samples available from your Kolbe dealer.